

✓

STATE OF MICHIGAN
DEPARTMENT
OF
NATURAL RESOURCES

LAND CORNER RECORD


CRAWFORD COUNTY
T 25 N R 2 W

DESCRIPTION OF CORNER W 1/4 corner, Section 23

CORNER MONUMENT Set Dept. Monument

DATE MONUMENT PLACED AND WITNESSED 7-16-71

WITNESSES TO CORNER..... 6" Oak S 80 E 34.1'

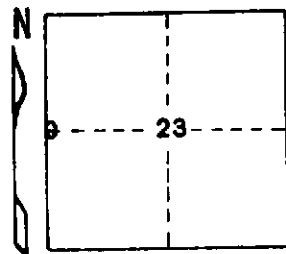

6" Oak S 18 W 9.8'


3" W. Pine S 22 E 77.6'

AND

CIRCLE CORNER REGISTERED

DESCRIPTION IN DETAIL AS TO HOW CORNER WAS LOCATED AND IDENTIFIED OR RESTORED.

Corner restored by proportionate measurement, M.P.O.L. between section corners, as intended by Henning survey of Sec. 22.

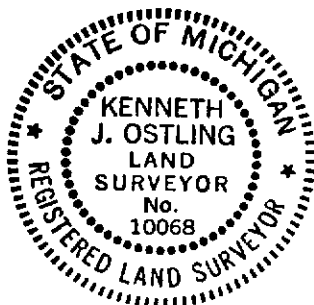

SURVEYOR'S SEAL

DISTRIBUTION:

County Courthouse
Area Forester (Regions I & II)
District or Region Surveyor
Forestry Div., Lansing

SIGNED

Kenneth J. Ostling
REGISTERED LAND SURVEYOR
10068

DATE

7-23-71