

STATE OF MICHIGAN
DEPARTMENT
OF
NATURAL RESOURCES
LAND CORNER RECORD

CRAWFORD COUNTY


T 25 N R 3 W

DESCRIPTION OF CORNER 1/4 Corner common to Sections 11-12

CORNER MONUMENT Left 1" iron bar in place

DATE MONUMENT PLACED AND WITNESSED 5-5-69

WITNESSES TO CORNER..... 4" J. Pine S 65 W 62.1'

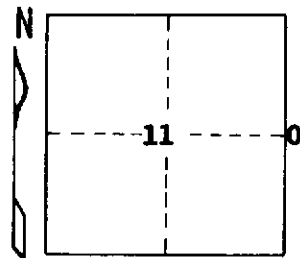

3" J. Pine N 43 W 86.0'

6" J. Pine S 45 E 159.4'

AND

CIRCLE CORNER REGISTERED

DESCRIPTION IN DETAIL AS TO HOW CORNER WAS LOCATED AND IDENTIFIED OR RESTORED.

This corner was found during a search for corners in this area. Found 1" iron bar at center of N-S-E road intersection, origin unknown. Appears to be accepted as corner.

SURVEYOR'S SEAL

SIGNED

Levitt Dething

DATE 7/25/69

REGISTERED LAND SURVEYOR 10068

DISTRIBUTION:

County Courthouse
Area Forester (Regions I & II)
District or Region Surveyor
Forestry Div., Lansing

R 4047
Rev. 10/68