

SURVEY &
REMONUMENTATION

APR 07 1998

LAND CORNER RECORDATION CERTIFICATE
Filing Requirement of Act 74, Mich. P.A. 1970

For corners in SECTION

Crawford Located In: Corner Code #
(County)

1. Public Land Survey T 26NR 2W A-2
T R
T R
T R

2. Property Controlling S T R
in Section S T R

3. Miscellaneous S T R
Property in Sec. S T R

4. Lot No. , Recorded Plat

5. Private Claims LIBER

STATE OF MICHIGAN
CRAWFORD COUNTY
RECORDED

19 DEC 97 2:37 P.M.

SANDRA MOORE
REGISTER OF DEEDS

Register of Deeds Stamp & File
Number

3 PAGE 287

I, Marvin E. Myers, in a field survey on 27 MAY, 1997 do hereby state that under requirements of P.A. 74, Michigan P.A. of 1970, the corner points mentioned in lines 1 and 2 above were in conformance with regulations and rules therefore as required in the current manual of survey instructions of the United States Department of the Interior, Bureau of Land Management or by a decree of a Court of Law and /or that the corner points mentioned in lines 3, 4 and 5 above were in conformance with the rules of the Michigan Board of Land Surveyors or by a Decree of a Court of Law; established, re-established, monumented, recovered, found as expressed below:

NOTE: Not more than 2 corners, all in the same town and range, may be recorded on this certificate.

A. Description of original monument and accessories and/or subsequent restoration:

G.L.O. 15 June 1852

Darwin A. Pettibone D.S.

Mon: Post

Wit: 7" Pine N71°W 26½ links

7" Pine S42°E 06 links

George D. Henning R.L.S.

Unrecorded Survey Sec.1 T26N R3W Oct 1955

Mon: Set ½" iron

Wit: Found old BT 10" J. Pine S77°E 20.5'

Found old BT 8" J. Pine N60°E 27.2'

Marked new BT 8" J. Pine N55°W 45.8'

Marked new BT 8" J. Pine S48°W 32.8'

George D. Henning R.L.S.

Unrecorded Survey Sec.6 T26N R2W Oct 1955

Mon: ½" bar

Wit: 10" J. Pine S77°E 20.5'

8" J. Pine N60°E 27.2'

8" J. Pine N55°W 45.8'

8" J. Pine S48°W 32.8'

B. Description of corner evidence found and/or method applied in restoring or reestablishing corner:

Found ½" bar and all of the G. D. Henning witness (now stumps) were found. Accepted position as a careful and faithful establishment of the position of the Corner. Replaced concrete monument with Standard Crawford County Monument.

C. Description of monument for corner and accessories established to perpetuate locating the position of the corner:

Mon - Standard Crawford County Monument

Wit - Set Carsonite post 2' North

Set spike in South face 4" Jack Pine N80°W 17.03'

Set spike in Northwest face 3" J. Pine S27°W 4.04'

Set spike in East face 8" J Pine N11°W 30.54'

Set spike in Southeast face 8" J. Pine N35°E 24.84'


CRAWFORD COUNTY

PEER GROUP APPROVAL

DATE OCT 16, 1997

Marvin E. Myers

Marvin E. Myers, P.S.
County Surveyor

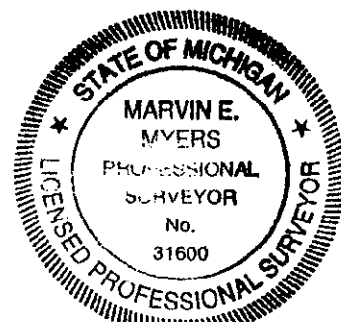

Signed by *Marvin E. Myers*
Surveyor's Michigan License No. 31600

Date Dec 16, 1997