

MICHIGAN
DEPARTMENT OF CONSERVATION
FORESTRY DIVISION

LAND CORNER RECORD

T. 27 N.R. 1 W


CRAWFORD COUNTY

DESCRIPTION OF CORNER 1/4 Corner Common to sections 16-17

CORNER MONUMENT Set DNR Monument

DATE MONUMENT PLACED AND WITNESSED 5-9-69

WITNESSES TO CORNER.....

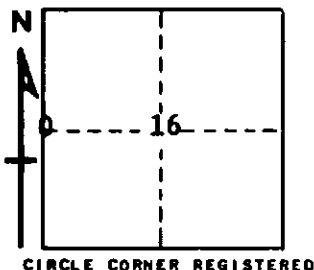

10" Cedar S 56 E 42.8'

7" Cedar N 36 E 48.4'

AND
OBT 20" Tam. S 84 W 5.1'

DESCRIPTION IN DETAIL AS TO HOW CORNER WAS LOCATED AND IDENTIFIED OR RESTORED.

This corner was located by Forestry Division Personnel. Previously perpetuated by Marcus Schaaf during surveys in 1930s. SW USBT stump in place with good face and scribe marks. Restored this date to perpetuate corner for control of future surveys.

SURVEYOR'S SEAL

SIGNED *Quentin J. Wittig* DATE 6-9-69
REGISTERED LAND SURVEYOR 10068