

LAND CORNER RECORDATION CERTIFICATE
Filing Requirement of Act 74, Mich. P.A. 1970

For corners in

.....Crawford.....
(County)

Located in:

Corner Code =//

- | | | T 27N | R 1W | I-12 |
|------------------------------------|---|-------|------|------|
| 1. Public Land Survey | | T | R | |
| | | T | R | |
| | | T | R | |
| | | T | R | |
| 2. Property Controlling in Section | S | T | R | |
| | S | T | R | |
| 3. Miscellaneous | S | T | R | |
| Property in Sec. | S | T | R | |

4. Lot No. _____, Recorded Plat _____
5. Private Claims _____

Norman C. Caldwell, in a field survey on March, 1990, do hereby certify that under requirements of P. A. 74, Michigan P. A. of 1970, the corner points mentioned in lines 1 and 2 above were in conformance with regulations and rules therefore as required in the current manual of survey instructions of the United States Department of the Interior, Bureau of Land Management or by a decree of a Court of Law and/or that the corner points mentioned in lines 3, 4 and 5 above were in conformance with the rules of the Michigan Board of Land Surveyors or by a Decree of a Court of Law; established, re-established, monumented, re-monumented, recovered, found as expressed below:

NOTE: Not more than 4 corners, all in the same town and range, may be recorded on this certificate.

A. Description of original monument and accessories and/or subsequent restoration:

(I-12) Post set by Pettibone, July 21, 1852.
Spruce Pine 13" N60°E .31 (20.46')
Spruce Pine 13" N85°W .49 (32.34')

B. Description of corner evidence found and/or method applied in restoring or reestablishing corner:

(I-12) LaGuire, 1934, placed pipe & conc. block mon. by proportion
Parker, LS 16939, fnd. LaGuire's position Dec. 6, 1974.
N40°E 74.25' 10" J. Pine
N44°W 130.02' 12" J. Pine
rec. in L 2, pg 103

C. Description of monument for corner and accessories established to perpetuate locating the position of the

(I-12) 1/4 cor. 34&35, T27N-R1W

Fnd. 1/2" bar utilized by local surv. for many yrs. reportedly placed by "LaGuire" Feb. 12, 1934, & appears to be utilized for all boundary surveys in this Sec. except plat of Scott's Lodge Sub., which is rec. in L 1 of plats & pg. 79&80. Accepted as the best available evidence of the position of the orig. corner. S70°E 42.0' 4" conc mon (Richardson)

West 10' Carsonite Witness Post

S40°E 40.9' 7" J. Pine

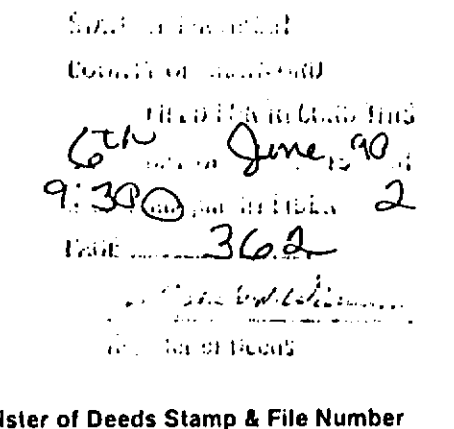
S65°E 85.8' 7" Oak (Richardson)

N65°E 77.1' 8" J. Pine (Richardson)

S15°E 17.26' 4" conc mon for 1/4 cor
as shown on plat of Scott's Lodge
Sub. L 1, of plats at pg. 79&80 by
Date Jas. E. Richardson LS 2527

Signed by _____ Date _____
Surveyor's Michigan License No. 12018 DATE: April 26, 1990

FORM APPROVED BY MICHIGAN STATE BOARD OF LAND SURVEYORS, JAN. 28, 1971
REVISED MAY 14, 1975
REVISED JAN., 1982

[illegible]