

LAND CORNER RECORDATION CERTIFICATE
FILING REQUIREMENT OF ACT 74, MICH. P.A.1970

FOR CORNERS OF—:	LOCATED IN—:	CORNER CODE NUMBER
1. PUBLIC LAND SURVEY_____	T. <u>27</u> ^{N.} S. , R. <u>3</u> ^{W.} E.	<u>L-5; M-5; M-6; M-7</u>
2. PROPERTY CONTROLLING IN SECTION_____	T. _____, N. <u> </u> , S. <u> </u> , R. _____, E. <u> </u> , W. <u> </u>	_____
3. MISCELLANEOUS PROPERTY IN SECTION_____	T. _____, N. <u> </u> , S. <u> </u> , R. _____, E. <u> </u> , W. <u> </u>	_____
4. LOT NO. _____, RECORDED PLAT _____		
5. PRIVATE CLAIMS _____		

REGISTER OF DEEDS STAMP AND
FILING NUMBER

I, Kenneth J. Ostling do hereby certify that under requirements of P.A. 74, Michigan P.A. of 1970, the corner points mentioned in lines 1 and 2 above (identified with circles on index code diagram—over) were, in a field survey on 5-10-73 19____, established, re-established, monumented, re-monumented, recovered or restored as expressed below and in conformance with regulations and rules therefore as required in the current manual of survey instructions of the United States Department of the Interior, Bureau of Land Management or by a decree of a court of law. Furthermore, that the corner points mentioned in lines 3, 4 and 5 above were, in a field survey on _____ 19____, found, recovered, restored, established or re-established as expressed below and in conformance with the rules of the Michigan State Board of Registration for Land Surveyors or, by a Decree of a Court of law:

A. Description of original monument and accessories and/or subsequent restoration:

B. Description of corner evidence found and/or method applied in restoring or re-establishing corner:

- L-5 Set corner by proportionate measurement between section corners. Nothing for prev.cor.
- M-5 Found Schaaf 1½" pipe in concrete at road intersection. Claimed to have US evidence to establish corner.
- M-6 Restored corner at position established in 1934 Schaaf survey, from his witness pits. Schaaf record indicates corner was set from identifiable U.S.B.T. stumps.
- M-7 Found 1½" pipe on conc. as estab. in Schaaf survey. Closing corner is 54.3' So and 3' West of this corner.
- C. Description of monument for corner and accessories established to perpetuate locating the position of the corner:


L-5 Set DNR Mon. 8" R. Oak N 30 W 25.5 6" W. Oak S 68 E 28.0	M-5 Set DNR Monument 9" R. Oak N 57 W 71.7 12" W. Oak S 22 W 83.1 12" R. Oak S 32 E 71.7	M-6 Set DNR Mon below surface 8" R. Oak S 87 E 73.4 20" R. Oak N 20 W 101.8
M-7 Set DNR mon below surface 9" R. Oak N 40 W 81.5 10" R. Oak S 80 W 93.8 8" R. Oak S 20 E 97.7		

SIGNED BY Kenneth J. Ostling DATE 5-10-73
SURVEYOR'S MICHIGAN REGISTRATION NO. 10068

FOR STATE AND UNITED STATES AGENCIES:

SIGNED BY _____ DATE _____
CHIEF OF SURVEY PARTY

APPROVED AND SIGNED BY _____ DATE _____
MICHIGAN REGISTERED LAND SURVEYOR

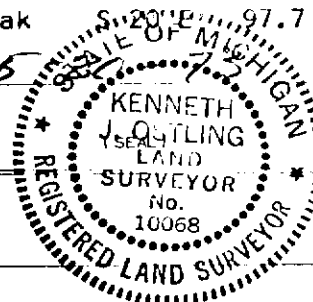

(SEAL)

SURVEYOR'S MICHIGAN REGISTRATION NO. _____