

APR 22 1999

LIBER

3 PAGE 346

SECTION

LAND CORNER RECORDATION CERTIFICATE  
Filing Requirement of Act 74, Mich. P.A. 1970

For corners in

Crawford  
(County)

Located In:

Corner Code #

1. Public Land Survey

T28N R4W

E-13

T27N R4W

E-1

T R

T R

2. Property Controlling  
in Section

S

T R

S

T R

3. Miscellaneous  
Property in Sec.

S

T R

S

T R

STATE OF MICHIGAN  
CRAWFORD COUNTY  
RECORDED

31 DEC 98 9:39 A.M.

SANDRA MOORE  
REGISTER OF DEEDS

Register of Deeds Stamp & File Num

4. Lot No. , Recorded Plat

5. Private Claims

I, James L. Schwandt, in a field survey on 10/15, 1998 hereby certify that under requirements of P.A. 74, Michigan P.A. of 1970, the corner points mentioned in lines 1 and 2 above were in conformance with regulations and rules therefore as required in the current manual of survey instructions of the United States Department of the Interior, Bureau of Land Management or by a decree of a Court of Law and/or that the corner points mentioned in lines 3, 4 and 5 above were in conformance with the rules of the Michigan Board of Land Surveyors or by a Decree of a Court of Law, established, re-established, monumented, re-monumented, recovered, found as expressed below:

|    | A | B  | C | D  | E | F  | G | H  | I | J  | K | L  |
|----|---|----|---|----|---|----|---|----|---|----|---|----|
| 1  |   |    |   |    |   |    |   |    |   |    |   |    |
| 2  |   | 6  |   | 5  |   | 4  |   | 3  |   | 2  |   | 1  |
| 3  |   |    |   |    |   |    |   |    |   |    |   |    |
| 4  |   | 7  |   | 8  |   | 9  |   | 10 |   | 11 |   | 12 |
| 5  |   |    |   |    |   |    |   |    |   |    |   |    |
| 6  |   | 18 |   | 17 |   | 16 |   | 15 |   | 14 |   | 13 |
| 7  |   |    |   |    |   |    |   |    |   |    |   |    |
| 8  |   | 19 |   | 20 |   | 21 |   | 22 |   | 23 |   | 24 |
| 9  |   |    |   |    |   |    |   |    |   |    |   |    |
| 10 |   | 30 |   | 29 |   | 28 |   | 27 |   | 26 |   | 25 |
| 11 |   |    |   |    |   |    |   |    |   |    |   |    |
| 12 |   | 31 |   | 32 |   | 33 |   | 34 |   | 35 |   | 36 |
| 13 |   |    |   |    |   |    |   |    |   |    |   |    |

A. Description of original monument and accessories and/or subsequent restoration:

- 1.) E-13, T28N-R4W; G.L.O. James Mullett, 1839; Set post; White Oak 10", N78°W, 13 links; Maple 8", N55°E, 2 links.
- 2.) A.E. Newman, 1900; White Oak 10", N78°W, 13 links; Maple 8", N55°E, 27 links.
- 3.) G.Houghton, 1923; Set Concrete filled tile with 1/2" bar at corner.
- 4.) Kenneth J. Ostling, #10068, 1974; Left concrete filled tile set by Houghton in place; 7" Red Oak, N85°E, 9.0'; 6" Red Oak, N33°W, 8.6'; 32" White Pine stump, N49°W, 35.3'; 15" White Pine stump, S38°W, 8.9'.


B. Description of corner evidence found and/or method applied in restoring or reestablishing corner:

- 1.) Found 1/2" bar in concrete filled tile; Found spike in 7.0" Oak, N50°E, 14.84'; Found spike in 7.0" Oak, N85°E 9.05'; Found spike in 7.0" Oak, S36°E, 9.53'; Found spike in 7.0" Oak, S5°W, 15.20'; Note: Found 2 spikes in all of these trees, we used bottom spikes for distances.; Found remains of White Pine stump, N49°W, 35.50'; Found remains of White Pine stump, S38°W, 8.0'.

C. Description of monument for corner and accessories established to perpetuate locating the position of the corner:

Mon: 1/2" bar in concrete filled tile left in place, accepted as the best available evidence of the position of the original corner.

Wit: Spike in 7.0" Oak, N50°E, 14.84'  
Spike in 7.0" Oak, N85°E, 9.05'  
Spike in 7.0" Oak, S36°E, 9.53'  
Spike in 7.0" Oak, S5°W, 15.20'  
Remains of White Pine stump, N49°W, 35.50'  
Remains of White Pine stump, S38°W, 8.0'

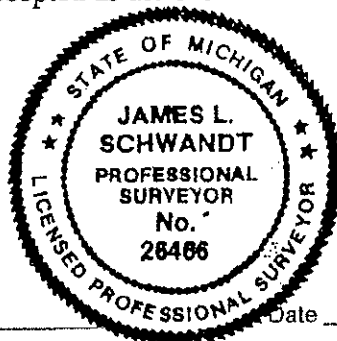

CRAWFORD COUNTY  
PEER GROUP APPROVAL  
DATE Aug 24, 1998

Marvin E. Myers  
Marvin E. Myers, P.S.  
County Surveyor

Signed by James L. Schwandt  
Surveyor's Michigan License No. 26466

Date 10-15-98