

APR 28 1999

LIBER

3 PAGE 352

SECTION

LAND CORNER RECORDATION CERTIFICATE
Filing Requirement of Act 74, Mich. P.A. 1970

For corners in

Crawford

(County)

Located In:

Corner Code #

1. Public Land Survey

T28N R4W

L-13

T27N R4W

L-1

2. Property Controlling
in Section

S

T R

S

T R

3. Miscellaneous
Property in Sec.

S

T R

S

T R

STATE OF MICHIGAN
CRAWFORD COUNTY
RECORDED

31 DEC 98 9:40 A.M.

SANDRA MOORE
REGISTER OF DEEDS

Register of Deeds Stamp & File Number

4. Lot No. _____, Recorded Plat _____

5. Private Claims _____

I, James L. Schwandt, in a field survey on 10/15, 1998 hereby certify that under requirements of P.A. 74, Michigan P.A. of 1970, the corner points mentioned in lines 1 and 2 above were in conformance with regulations and rules therefore as required in the current manual of survey instructions of the United States Department of the Interior, Bureau of Land Management or by a decree of a Court of Law and for that the corner points mentioned in lines 3, 4 and 5 above were in conformance with the rules of the Michigan Board of Land Surveyors or by a Decree of a Court of Law; established, re-established, monumented, re-monumented, recovered, found as expressed below:

	A	B	C	D	E	F	G	H	I	J	K	L
1												
2	6		5		4		3		2		1	
3												
4	7		8		9		10		11		12	
5												
6	18		17		16		15		14		13	
7												
8	19		20		21		22		23		24	
9												
10	30		29		28		27		26		25	
11												
12	31		32		33		34		35		36	
13												

A. Description of original monument and accessories and/or subsequent restoration:

- 1.) L-13, T28N-R4W; G.L.O. James H. Mullett, 1839; Set Post; Beech 10", N56°W, 33 links; Beech 8", N59°E, 17 links.
- 2.) Kenneth J. Ostling, #10068, 1972; Set DNR Mon. by Prop. Measurement.
- 3.) Norman F. Parker, #16939, 1974; Used corner in survey recorded in Liber 140, Page 423, Crawford County Records; No description or witnesses were listed.

B. Description of corner evidence found and/or method applied in restoring or reestablishing corner:


- 1.) Found DNR Monument, 25.0' West and 10.0' South of XX Trail Roads; No witnesses.

CRAWFORD COUNTY
PEER GROUP APPROVAL
DATE Dec 21, 1998

Marvin E. Myers
Marvin E. Myers, P.S.
County Surveyor

C. Description of monument for corner and accessories established to perpetuate locating the position of the corner:

Mon: DNR Monument left in place, accepted as the best available evidence of the position of the original corner.
Wit: Set spike and blaze, 5.0" Cherry, N15°E, 27.64'
Set spike and blaze, 10.0" Poplar, West, 2.49'
Set spike and blaze, 4.0" Ironwood, S3°E, 12.69'
Set spike and blaze, 10.0" Poplar, S30°E, 11.41'

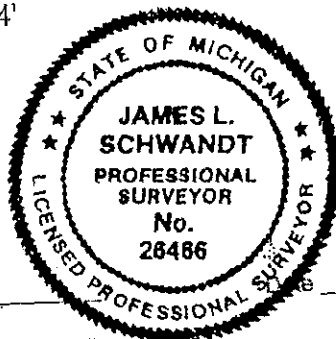

Signed by

James L. Schwandt

Surveyor's Michigan License No.

26466

10-15-98