

STATE OF MICHIGAN
DEPARTMENT
OF
NATURAL RESOURCES
LAND CORNER RECORD


CRAWFORD COUNTY
T 28 N R 4 W

DESCRIPTION OF CORNER East 1/4 Corner, Sec. 26

CORNER MONUMENT Left 4" Concrete Monument in place

DATE MONUMENT PLACED AND WITNESSED 5-25-72

WITNESSES TO CORNER.....

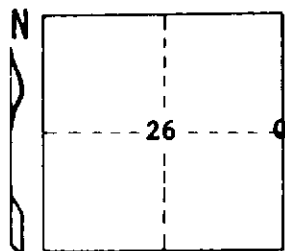

8" W. Birch N 10 W 14.0'


7" W. Birch S 30 W 40.2'

AND

CIRCLE CORNER REGISTERED

DESCRIPTION IN DETAIL AS TO HOW CORNER WAS LOCATED AND IDENTIFIED OR RESTORED.

Left concrete monument in place as established in 1950 survey by Henning, who placed it in the general line of an old fence running West through Section 26. Some surveys based on this location and felt it must be used for control, at this time.

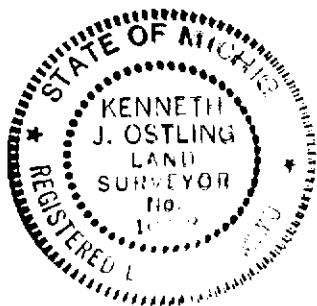

SURVEYOR'S SEAL

SIGNED Kenneth J. Ostling DATE 5-31-72
REGISTERED LAND SURVEYOR 10068

DISTRIBUTION:

Forestry Division, Lansing