

SURVEY & REMONUMENTATION

OCT 18 1996

COMMISSION

LAND CORNER RECORDATION CERTIFICATE
Filing Requirement of Act 74, Mich. P.A. 1970

STATE OF MICHIGAN
COUNTY OF CHARLEVOIX
RECEIVED FOR RECORD

96 OCT 14 AM 10:21

Charles M. Cookin
REGISTER OF DEEDS

For corners in

Charlevoix
(County)

Located in:

Corner Code #

1. Public Land Survey

T32NR 4W

J-3

T R

T R

T R

2. Property Controlling
in Section

S

T R

S

T R

3. Miscellaneous
Property in Sec.

S

T R

S

T R

4. Lot No. , Recorded Plat

5. Private Claims

I, James E. Evans, in a field survey on November 24, 1995, do hereby state that under requirements of P.A. 74, Michigan P.A. of 1970, the corner points mentioned in lines 1 and 2 above were in conformance with regulations and rules therefore as required in the current manual of survey instructions of the United States Department of the Interior, Bureau of Land Management or by a decree of a Court of Law and/or that the corner points mentioned in lines 3, 4 and 5 above were in conformance with the rules of the Michigan Board of Land Surveyors or by a Decree of a Court of Law; established, re-established, monumented, recovered, found as expressed below:

NOTE: Not more than 2 corners, all in the same town and range, may be recorded on this certificate.

Register of Deeds Stamp & File Number

	A	B	C	D	E	F	G	H	I	J	K	L	M
1													
2		6		5		4		3		2		1	
3													
4		7		8		9		10		11		12	
5													
6		18		17		16		15		14		13	
7													
8		19		20		21		22		23		24	
9													
10		30		29		28		27		26		25	
11													
12		31		32		33		34		35		36	
13													

A. Description of original monument and accessories and/or subsequent restoration:
J-3 QUARTER CORNER COMMON TO SEC 2 and 11 T32N-R4W

GLO: Set Elm Quarter post
10" Sugar N70°W 36 lks (23.76')
6" Sugar S71°W 4 lks (2.64')
by William Burt, DS, 1850

B. Description of corner evidence found and/or method applied in restoring or reestablishing corner:


No evidence found of GLO post or witnesses. Established corner J-3 on line between corners I-3 and K-3, T32N R4W at 40 chains (2640.00 feet) West of corner K-3.

C. Description of monument for corner and accessories established to perpetuate locating the position of the corner:

Set Charlevoix County cast iron monument in monument box.

20" Maple N46°W 69.52' set nail & cap #16034
9" Maple N40°E 56.33' set nail & cap #16034
9" Red Pine S48°E 81.40' set nail & cap #16034
6" Jack Pine N02°E 53.70' set nail & cap #16034

Charlevoix Co. Surveyor
APPROVED
Signatures Mary C. Feendt
Date: 10-10-96

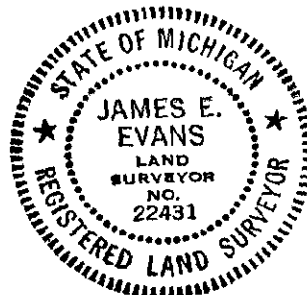

And is accepted as the best available evidence of the position of the original corner.

Signed by

Surveyor's Michigan License No. 22431

Date

10-10-96

FORM APPROVED BY MICHIGAN STATE BOARD OF PROFESSIONAL SURVEYORS, JAN. 28, 1971
REVISED MAY 14, 1975
REVISED JAN., 1983
REVISED OCT., 1990

LIBEF 003 PAGE 44