

## REMONUMENTATION

APR 06 1995

2-358

## COMMISSION

## LAND CORNER RECORDATION CERTIFICATE

Filing Requirement of Act 74, Mich. P.A. 1970

Hudson Township

For corners in  
CHARLEVOIX

(County)

Located In:

Corner Code #

32N 4W

K-1/2 MC

(001)

STATE OF MICHIGAN  
COUNTY OF CHARLEVOIX  
RECEIVED FOR RECORD

1994 DEC 22 PM 2:31

Charlotte M. Cashin  
REGISTER OF DEEDS

Register of Deeds Stamp &amp; File Number

1. Public Land Survey

T R

T R

T R

T R

2. Property Controlling  
in Section

S T R

S T R

3. Miscellaneous  
Property in Sec.

S T R

S T R

Other #1

4. Lot No. , Recorded Plat

5. Private Claims

George J. Avendt, JR.

NOV. 12

1994

I, , in a field survey on , 19 ,

do hereby certify that under requirements of P.A. 74, Michigan P.A. of 1970, the corner points mentioned in lines 1 and 2 above were in conformance with regulations and rules therefore as required in the current manual of survey instructions of the United States Department of the Interior, Bureau of Land Management or by a decree of a Court of Law and/or that the corner points mentioned in lines 3, 4 and 5 above were in conformance with the rules of the Michigan Board of Land Surveyors or by a Decree of a Court of Law; established, re-established, monumented, re-monumented, recovered, found as expressed below:

**NOTE: Not more than 4 corners, all in the same town and range, may be recorded on this certificate.**

	A	B	C	D	E	F	G	H	I	J	K	L	M
2	6	5	4	3	2	1							
3													
4	7	8	9	10	11	12							
5													
6	13	14	15	16	17	18							
7													
8	19	20	21	22	23	24							
9													
10	25	26	27	28	29	30							
11													
12	31	32	33	34	35	36							
13													

A. Description of original monument and accessories and/or subsequent restoration:

K-1/2 MC COMMON TO SEC'S. 1 &amp; 2, T32N, R4W.

SURVEYED IN 1850 BY WILLIAM BURT, DS - G.L.O. HEMLOCK TREE USE AS MEANDER POST ON THE NORTH SIDE OF LAKE

BIRCH 8" N62°W 14 LINKS ( 9.24' ) - HEMLOCK 6" N75°E 18 LINKS (11.88')

SURVEY BY GEORGE J. AVENDT, JR, PS 16034 IN 1986. NO EVIDENCE FOUND OF HEMLOCK TREE MEANDER CORNER OF THE BEARING TREES. SET CHARLEVOIX COUNTY SURVEY MARKER ON LINE COMMON TO SECTIONS 1 & 2 AT G.L.O. DISTANCE 34.40 CHAINS (2270.') SOUTH OF NORTHEAST CORNER OF SEC. 2. WITNESSES ARE TO NAILS & TAGS IN TREES. S41°E 29.75' 4" CEDAR - N63°W 20.49' 4" CEDAR - N20°W 14.34' 12" W.BIRCH - N88°E 85.88' 10" W.PINE - SOUTH 31.3' WATER'S EDGE Liber 2, Page 242

B. Description of corner evidence found and/or method applied in restoring or reestablishing corner:

K-1/2 MC COMMON TO SEC'S. 1 &amp; 2, T32N, R4W.

NO EVIDENCE FOUND OF HEMLOCK TREE MEANDER CORNER OF THE BEARING TREES. FOUND CHARLEVOIX COUNTY SURVEY MARKER ON LINE COMMON TO SECTIONS 1 & 2 AT G.L.O. DISTANCE 34.40 CHAINS (2270.') SOUTH OF NORTHEAST CORNER OF SECTION 2.

Charlevoix Co. Surveyor

APPROVED

Signature Mary C. FennellDate: Dec. 8, 1994

P.A. 345 of 1990

C. Description of monument for corner and accessories established to perpetuate locating the position of the corner:

K-1/2 MC COMMON TO SEC'S. 1 &amp; 2, T32N, R4W.

FOUND CHARLEVOIX COUNTY MONUMENT.

WITNESSES ARE TO NAILS AND TAGS IN TREES.

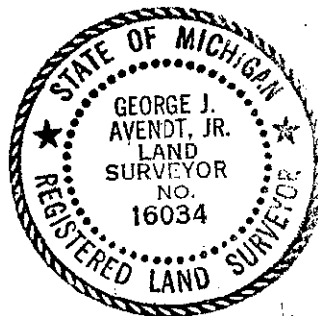
S41°E 29.75' 4" CEDAR

N63°W 20.49' 4" CEDAR

N20°W 14.34' 12" W.BIRCH

N88°E 85.88' 10" W.PINE

SOUTH 31.3' WATER'S EDGE

Signed by George J. Avendt, Jr.Date Dec. 1994

Surveyor's Michigan License No. 16034

LIBER 002 PAGE 358

FORM APPROVED BY MICHIGAN STATE BOARD OF LAND SURVEYORS, JAN. 28, 1971  
REVISED MAY 14, 1975  
REVISED JAN., 1983