

SURVEY &
REMONUMENTATION

APR 06 1995

LAND CORNER RECORDATION CERTIFICATE
Filing Requirement of Act 74, Mich. P.A. 1970

Hudson Township

For corners in
CHARLEVOIX

(County)

Located In:

Corner Code #

1. Public Land Survey

32N 4W

I/J-3 MC

2. Property Controlling
in Section

S T R

3. Miscellaneous

S T R

Property in Sec.

S T R

4. Lot No. , Recorded Plat

5. Private Claims

STATE OF MICHIGAN
COUNTY OF CHARLEVOIX
RECEIVED FOR RECORD

1994 DEC 22 PM 2:28

Charlene M. Beckin
REGISTER OF DEEDS

Register of Deeds Stamp & File Number

George J. Avendt, JR.

NOV. 11

1994

I, _____, in a field survey on _____, 19_____, do hereby certify that under requirements of P.A. 74, Michigan P.A. of 1970, the corner points mentioned in lines 1 and 2 above were in conformance with regulations and rules therefore as required in the current manual of survey instructions of the United States Department of the Interior, Bureau of Land Management or by a decree of a Court of Law and/or that the corner points mentioned in lines 3, 4 and 5 above were in conformance with the rules of the Michigan Board of Land Surveyors or by a Decree of a Court of Law; established, re-established, monumented, re-monumented, recovered, found as expressed below:

NOTE: Not more than 4 corners, all in the same town and range, may be recorded on this certificate.

A. Description of original monument and accessories and/or subsequent restoration:

I/J-3 MC COMMON TO SEC'S. 2 & 11 T32N, R4W.

SURVEYED IN 1850 BY WILLIAM BURT, DS - G.L.O SET HEMLOCK MEANDER POST

HEMLOCK 15" S26°E 15 LINKS (9.9')

HEMLOCK 16" N55°E 25 LINKS (16.5')

	A	B	C	D	E	F	G	H	I	J	K	L	M
2	5	5	4	3	2	1							
3													
4	7	8	9	10	11	12							
5	18	17	16	15	14	13							
6													
7													
8	19	20	21	22	23	24							
9													
10	30	29	28	27	26	25							
11													
12	31	32	33	34	35	36							
13													

B. Description of corner evidence found and/or method applied in restoring or reestablishing corner:

I/J-3 MC COMMON TO SEC'S. 2 & 11 T32N, R4W.

FOUND 4" CONCRETE MONUMENT FLUSH WITH THE GROUND ON BLUFF LINE OF EASTERLY SHORE OF THUMB LAKE (A.K.A LAKE LOUISE). ORIGIN OF 4" CONCRETE MONUMENT UNKNOWN. NO EVIDENCE WAS FOUND OF G.L.O. POST AND WITNESS TREES.

Charlevoix Co. Surveyor

APPROVED

Signature Mary C. Fennell

Date: DEC 8 1994

P.A. 345 1990

C. Description of monument for corner and accessories established to perpetuate locating the position of the corner:

I/J-3 MC COMMON TO SEC'S. 2 & 11 T32N, R4W.

FOUND 4" CONCRETE MONUMENT

N42°W 1.28' 18" HEMLOCK/CAP #16034


S40°E 18.60' NW COR. VERTICAL LOG CABIN #6

S13°E 32.50' SW COR. VERTICAL LOG CABIN #6

N43°E 21.51' SW COR. HORIZONTAL LOG CABIN #7

N22°E 34.15' NW COR. HORIZONTAL LOG CABIN #7

WESTERLY 43'± WATER'S EDGE OF THUMB LAKE (A.K.A. LAKE LOUISE)

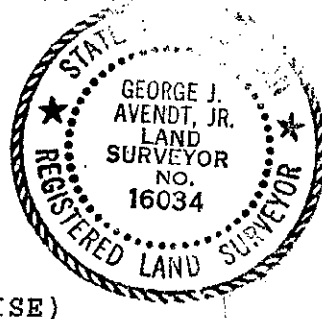

Signed by George J. Avendt, Jr.

Date 8 DEC 1994

Surveyor's Michigan License No. 16034

LIBER 002 PAGE 354