

SURVEY & REMONUMENTATION COMMISSION
APR 06 1995
For corners in CHARLEVOIX (County)

2-344

LAND CORNER RECORDATION CERTIFICATE
Filing Requirement of Act 74, Mich. P.A. 1970

Boyne Valley Township

STATE OF MICHIGAN
COUNTY OF CHARLEVOIX
RECEIVED FOR RECORD

1994 DEC 22 PM 2:19

Charlene M. Pasch
REGISTER OF DEEDS

Register of Deeds Stamp & File Number

1. Public Land Survey	Located In:	Corner Code #
	T 32N R 5W	A-4
	T R	
	T R	
	T R	
	T R	
2. Property Controlling In Section	S T R	
	S T R	
3. Miscellaneous Property in Sec.	S T R	
	S T R	

4. Lot No. , Recorded Plat
5. Private Claims

George J. Avendt, JR. NOV. 22 1994

I, in a field survey on 19 do hereby certify that under requirements of P.A. 74, Michigan P.A. of 1970, the corner points mentioned in lines 1 and 2 above were in conformance with regulations and rules therefore as required in the current manual of survey instructions of the United States Department of the Interior, Bureau of Land Management or by a decree of a Court of Law and/or that the corner points mentioned in lines 3, 4 and 5 above were in conformance with the rules of the Michigan Board of Land Surveyors or by a Decree of a Court of Law; established, re-established, monumented, re-monumented, recovered, found as expressed below:

NOTE: Not more than 4 corners, all in the same town and range, may be recorded on this certificate.

	A	B	C	D	E	F	G	H	I	J	K	L	M
2	6	5	4	3	2	1							
3													
4	7	8	9	10	11	12							
5													
6	13	17	16	15	14	13							
7													
8	19	20	21	22	23	24							
9													
10	30	29	28	27	26	25							
11													
12	31	32	33	34	35	36							
13													

A. Description of original monument and accessories and/or subsequent restoration:

A-4 QUARTER CORNER COMMON TO SEC. 7, T32N, R5W. & SEC. 12, T32N, R6W.
SURVEYED IN 1839 BY JOHN HODGSON, DS - G.L.O. - SECTION CORNER POST
BEECH 12" S40°W 5 LINKS (3.3') - BEECH 8" N30°W 8 LINKS (5.28')

B. Description of corner evidence found and/or method applied in restoring or reestablishing corner:


A-4 QUARTER CORNER COMMON TO SEC. 7, T32N, R5W. & SEC. 12, T32N, R6W.
FOUND 1/2" IRON ROD NO CAP & POINTED ROCK. OLD FENCE NORTH & EAST. ORIGIN UNKNOWN.

Charlevoix Co. Surveyor
APPROVED
Signature Mary C. Burnett
Date: Dec. 8, 1994
P.A. 345 of 1990

C. Description of monument for corner and accessories established to perpetuate locating the position of the corner:

A-4 QUARTER CORNER COMMON TO SEC. 7, T32N, R5W. & SEC. 12, T32N, R6W.
FOUND 1/2" IRON ROD. REPLACED WITH CHARLEVOIX COUNTY MONUMENT.

- S70°E 8.30' 24" BEECH/CAP # 16034
- S25°E 16.24' 7" MAPLE/CAP # 16034
- S66°W 8.89' 4" BEECH/CAP # 16034
- N56°W 8.23' 7" BEECH/CAP # 16034

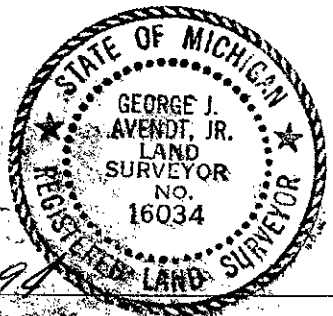

Signed by George J. Avendt, Jr.
Surveyor's Michigan License No. 16034

Date 8 DEC. 1994

LIBER 002 PAGE 344