

SURVEY & REMONUMENTATION

JAN 26 1998

SECTION

LAND CORNER RECORDATION CERTIFICATE Filing Requirement of Act 74, Mich. P.A. 1970

STATE OF MICHIGAN
COUNTY OF CHARLEVOIX
RECEIVED FOR RECORD

97 DEC 15 PM 2:54

Charles M. Bosser
REGISTER OF DEEDS

For corners in

Charlevoix

Located In:

Corner Code #

(County)

1. Public Land Survey

T 32NR 7W

M-11

T R

A-11

T 32NR 6W

T R

S T R

S T R

S T R

S T R

2. Property Controlling in Section

3. Miscellaneous Property in Sec.

4. Lot No. , Recorded Plat

5. Private Claims

Wayne E. Boss

May

97

I, Wayne E. Boss, in a field survey on May, 1997, do hereby state that under requirements of P.A. 74, Michigan P.A. of 1970, the corner points mentioned in lines 1 and 2 above were in conformance with regulations and rules therefore as required in the current manual of survey instructions of the United States Department of the Interior, Bureau of Land Management or by a decree of a Court of Law and for that the corner points mentioned in lines 3, 4 and 5 above were in conformance with the rules of the Michigan Board of Land Surveyors or by a Decree of a Court of Law; established, re-established, monumented, recovered, found as expressed below:

NOTE: Not more than 2 corners, all in the same town and range, may be recorded on this certificate.

Register of Deeds Stamp & File Number

	A	B	C	D	E	F	G	H	I	J	K	L	M
1													
2	6		5		4		3		2		1		
3													
4	7		8		9		10		11		12		
5													
6	18		17		16		15		14		13		
7													
8	19		20		21		22		23		24		
9													
10	30		29		28		27		26		25		
11													
12	31		32		33		34		35		36		
13													

A. Description of original monument and accessories and/or subsequent restoration:

M-11 OCTOBER 1856

E.D. ATWATER, DEPUTY SURVEYOR

1. HEMLOCK 11 INCH S71W 19 LKS.

2. SUGAR 9 INCH N53 1/2W 16 LKS.

3. NO OLD CORNER FOUND

JANUARY 1958

THOMAS F. SCHWEIGART, R.L.S.

FD. 1" IR IN C.L. M-32

3. POWER POLE S57E 65.4'

4. POWER POLE N75W 90.8'

5. T-IRON NORTH 33.00'

FD. 5/8" IR BURIED 1" UNDER ASPH.

6. 15" MAPLE CLUMP N17W 69.02'

7. 9" MAPLE N40W 71.40'

8. TELEPHONE POLE S65W 65.86'

9. 24" CHERRY S07E 102.79'

JUNE 22, 1993 NICHOLAS B. DEYOUNG FD. 5/8" IR 3. POWER POLE S53E 65.67' 6. 8" MAPLE N20W 69.00'

B. Description of corner evidence found and/or method applied in restoring or reestablishing corner:

(SEE BACK) Charlevoix Co. Surveyor

APPROVED

Signature *Mary C. Farrell*

Date: 12/13/97

M-11 NOVEMBER 1996

FD. 1/2"X18" PIPE IN MONUMENT BOX

5. 1/2" IR NORTH 33.00' NO CAP

6. 12" MAPLE CLUMP N17W 69.0'

7. 14" MAPLE N40W 71.0' WITH TAG #14200

9. 32" CHERRY S07E 101.88' WITH TAG 14200

11. POWER POLE N81E 115.83' WITH TAG 20705

12. CHAIN LINK ANCHOR POST S62W 82.05'

13. CHAIN LINK ANCHOR POST S35W 85.00'

14. 11" RED PINE S60E 99.10' FD. NAIL & CAP 16034

GLO M-11 TO M-12 2640 MEASURE 2633.17'

GLO M-11 TO M-10 2640 MEASURE 2624.69'

C. Description of monument for corner and accessories established to perpetuate locating the position of the corner:

M-11 1/2" PIPE REPLACED WITH STEEL CHARLEVOIX COUNTY MARKER IN MONUMENT BOX

5. 1/2" IR NORTH 33.00'

6. 12" MAPLE CLUMP N17W 69.0'

7. 14" MAPLE N40W 71.1' WITH TAG 14200

9. 32" CHERRY S07E 101.88' WITH TAG 14200

11. POWER POLE N81E 115.83' WITH TAG 20705

12. CHAIN LINK ANCHOR POST S62W 82.05'

AND IS ACCEPTED AS A CAREFUL & FAITHFUL REESTABLISHMENT OF THE POSITION OF THE ORIGINAL

CORNER

13. CHAIN LINK ANCHOR POST S35W 85.00'

14. 11" RED PINE S60E 99.10' FD. NAIL & CAP 16034


Signed by

Surveyor's Michigan License No.

20703

Date

12/13/97

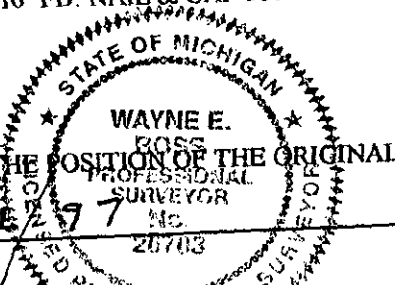

Apr 20

M-11 APRIL 20, 1994
JAMES E. EVANS, P.S. 22431
FD. 5/8' IRON IN MONUMENT BOX
5. FD. 1/2" IR NORTH 33.00'
11. POWER POLE N82E 115.83' FD. NAIL & TAG 20705
12. CHN. LNK ANCHOR POST
13. CHN. LNK. ANCHOR POST S35W 85.00'
14. 11" RED PINE S60E 99.10' SET NAIL & TAG 16034