

SURVEY &  
REMONUMENTATION

JAN 26 1998

SECTION

LAND CORNER RECORDATION CERTIFICATE  
Filing Requirement of Act 74, Mich. P.A. 1970

STATE OF MICHIGAN  
COUNTY OF CHARLEVOIX  
RECEIVED FOR RECORD

97 DEC 15 PM 2:44

*Charlotte M. Bosh*  
REGISTER OF DEEDS

For corners in

Charlevoix

(County)

Located In:

Corner Code #

1. Public Land Survey

T 32N R 7W MC S. OF LAKE  
BTWN. A6-A7  
T 32N R 8W MC S. OF LAKE  
BTWN. M6-M7

2. Property Controlling  
in Section

S T R  
S T R #19

3. Miscellaneous  
Property in Sec.

S T R  
S T R

Register of Deeds Stamp & File Number

4. Lot No. , Recorded Plat

5. Private Claims

Wayne E. Boss

May 97

I, Wayne E. Boss, in a field survey on May 97, 1997 do hereby state that under requirements of P.A. 74, Michigan P.A. of 1970, the corner points mentioned in lines 1 and 2 above were in conformance with regulations and rules therefore as required in the current manual of survey instructions of the United States Department of the Interior, Bureau of Land Management or by a decree of a Court of Law and /or that the corner points mentioned in lines 3, 4 and 5 above were in conformance with the rules of the Michigan Board of Land Surveyors or by a Decree of a Court of Law, established, re-established, monumented, recovered, found as expressed below:

NOTE: Not more than 2 corners, all in the same town and range, may be recorded on this certificate.

A. Description of original monument and accessories and/or subsequent restoration:

MEANDER CORNER SOUTH OF WEST QUARTER CORNER SECTION 18 ON SOUTH SIDE OF LAKE  
OCTOBER 1856

E.D. ATWATER, DEPUTY SURVEYOR

SET BLACK ASH POST 3 INCH

1. B.ASH 10 INCH S37 1/2E 25 LNK.

2. B.ASH 8 INCH S53W 35 LNKs.

B. Description of corner evidence found and/or method applied in restoring or reestablishing corner:

MEANDER CORNER SOUTH OF A-6 AT SOUTH SIDE OF LAKE

NO EVIDENCE OF ORIGINAL CORNER FOUND OR WITNESSES  
ORIGINAL POSITION ON LINE BETWEEN CORNERS A-6 AND A-7 USING GLO CHAINAGE  
OF 30.47 CHAINS FALLS IN LAKE. NEW CORNER PLACED ON LINE IN SOLID GROUND  
AT 2085.00' SOUTH OF EAST EAST QUARTER CORNER OR 31.59 CHAINS

MEANADER CORNER NORTH OF LAKE TO NEW MEADER CORNER SOUTH OF LAKE  
531.36'. NEW MEANDER CORNER TO A-7 IS 561.83'

C. Description of monument for corner and accessories established to perpetuate locating the position of the corner:

MEANDER CORNER SOUTH OF A-6 AT SOUTH SIDE OF LAKE

PLACED STEEL CHARLEVOIX COUNTY MARKER

5" ELM S08E 26.80' SET NAIL & TAG


6" ELM N76E 19.56' SET NAIL & TAG

16" W.ASH N68W 49.83' SET NAIL & TAG

17" POPLAR S73W 50.85 SET NAIL & TAG AND FD. EVIDENCE OF OLD NORTH-SOUTH FENCE

WATER'S EDGE NORTH 48' +/-

AND IS ACCEPTED AS A CAREFUL & FAITHFUL REESTABLISHMENT OF THE POSITION OF THE CORNER

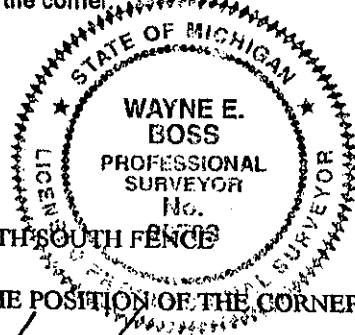

Signed by Wayne E. Boss

Date 12/12/97

Surveyor's Michigan License No. 20703

LIBER 003 PAGE 127