

98 SEP 15 AM 10:03

LAND CORNER RECORDATION CERTIFICATE  
Filing Requirement of Act 74, Mich. P.A. 1970

For corners in

Charlevoix  
(County)

Located in:

Corner Code #

## 1. Public Land Survey

T<sup>32N</sup> R<sup>7W</sup>

MC W OF D-13

T<sup>31N</sup> R<sup>7W</sup>

MC W OF D-1

2. Property Controlling  
in Section

S

T

R

S

T

R

3. Miscellaneous  
Property in Sec.

S

T

R

S

T

R

Charles M. Boss  
REGISTER OF DEEDS

Register of Deeds Stamp &amp; File Number

4. Lot No. \_\_\_\_\_, Recorded Plat \_\_\_\_\_

5. Private Claims \_\_\_\_\_

I, Wayne E. Boss, in a field survey on June, 1998 do hereby state that under requirements of P.A. 74, Michigan P.A. of 1970, the corner points mentioned in lines 1 and 2 above were in conformance with regulations and rules therefore as required in the current manual of survey instructions of the United States Department of the Interior, Bureau of Land Management or by a decree of a Court of Law and/or that the corner points mentioned in lines 3, 4 and 5 above were in conformance with the rules of the Michigan Board of Land Surveyors or by a Decree of a Court of Law; established, re-established, monumented, recovered, found as expressed below:

NOTE: Not more than 2 corners, all in the same town and range, may be recorded on this certificate.

	A	B	C	D	E	F	G	H	I	J	K	L
1												
2	6			5		4		3		2		1
3												
4	7			8		9		10		11		12
5												
6	18			17		16		15		14		13
7												
8	19			20		21		22		23		24
9												
10	30			29		28		27		26		25
11												
12	31			32		33		34		35		36
13												

## A. Description of original monument and accessories and/or subsequent restoration:

## MEANDER CORNER EAST OF LAKE

OCTOBER 23, 1856

EDWARD D. ATWATER, DEPUTY SURVEYOR

SET POST EAST OF LAKE

HEMLOCK 11 INCH N47 1/2°E 20 LINKS

HEMLOCK 12 INCH S70°E 28 LINKS

1926 E.A. ROBINSON, SURVEYOR

DEPICTS OBJECTS ON DRAWING AT MEANDER CORNER

AND 370' EAST OF MEANDER CORNER

Charlevoix Co. Surveyor  
APPROVEDSignature Mary C. Fenn  
Date: Aug. 13, 1998

## B. Description of corner evidence found and/or method applied in restoring or reestablishing corner:

## MEANDER CORNER EAST OF LAKE

FEB. 20, 1998 NO EVIDENCE OF OLD MEANDER CORNER WAS FOUND

FOUND 2" PIPE BURIED 1 FOOT BELOW GRAVEL ROAD SURFACE 379.69' EAST OF GOVERNMENT

LAND OFFICE MEANDER CORNER.

EXTENDED LINE FROM CORNER AT D-13 THROUGH 2" PIPE AS FOUND WESTERLY TO EAST SHORE OF SIX MILE LAKE.

D-13 TO MEANDER CORNER GLO 37.50 CHAINS (2475.0') MEASURES S°9°58'35"W 2473.16'

MEANDER CORNER TO M.C. WEST OF LAKE GLO 18.78 CHAINS (1239.48') MEAS. N89°27'36"W 1300.35'

## C. Description of monument for corner and accessories established to perpetuate locating the position of the corner:

## MEANDER CORNER EAST OF LAKE

PLACED STEEL CHARLEVOIX COUNTY MARKER


1/2" IRON ROD S10°E 50.94'

NW COR OF HOUSE #5979 N55°E 30.93' SET NAIL &amp; TAG

SW COR OF WOODEN DECK S35°E 21.35' SET NAIL &amp; TAG

TRIPPLE 24" WILLOW S29°E 96.66' SET NAIL &amp; TAG IN E. FACE

EDGE OF LAKE WEST 4.8' FIELD STONE RETAINING WALL ADJACENT LAKE

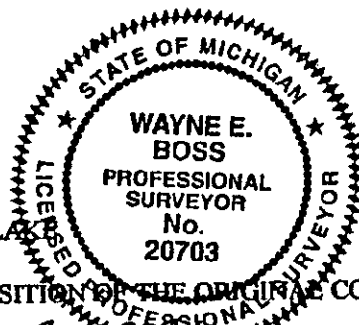

AND IS ACCEPTED AS A CAREFUL &amp; FAITHFUL REESTABLISHMENT OF THE POSITION OF THE ORIGINAL CORNER

Signed by Wayne E. BossDate Aug 29, 1998Surveyor's Michigan License No. 20703