

FEB 22 2001

STATE OF MICHIGAN  
COUNTY OF CHARLEVOIX  
RECEIVED FOR RECORD

96 DEC 11 PH 2:57

SECTION

LAND CORNER RECORDATION CERTIFICATE

Filing Requirement of Act 74, Mich. P.A. 1970

For corners in  
Charlevoix

(County)

Located In:

Corner Code #

1. Public Land Survey

T 32N R 7W  
T 33N R 7W

E-1 ✓  
E-13

2. Property Controlling  
in Section

S T R  
S T R

3. Miscellaneous  
Property in Sec.

S T R  
S T R

4. Lot No. , Recorded Plat

5. Private Claims

REGISTER OF DEEDS

Register of Deeds Stamp & File Number

	A	B	C	D	E	F	G	H	I	J	K	L	M
2	6	5	4	3	2	1							
3													
4	7	8	9	10	11	12							
5													
6	18	17	16	15	14	13							
7													
8	19	20	21	22	23	24							
9													
10	30	29	28	27	26	25							
11													
12	31	32	33	34	35	36							
13													

I, Wayne E. Boss, in a field survey on OCTOBER 18, 19 96, do hereby certify that under requirements of P.A. 74, Michigan P.A. of 1970, the corner points mentioned in lines 1 and 2 above were in conformance with regulations and rules therefore as required in the current manual of survey instructions of the United States Department of the Interior, Bureau of Land Management or by a decree of a Court of Law and/or that the corner points mentioned in lines 3, 4 and 5 above were in conformance with the rules of the Michigan Board of Land Surveyors or by a Decree of a Court of Law; established, re-established, monumented, re-monumented, recovered, found as expressed below:

NOTE: Not more than 4 corners, all in the same town and range, may be recorded on this certificate.

A. Description of original monument and accessories and/or subsequent restoration:

E-1 GLO JUNE 1839 JOHN HODGSON, SET COR. POST 1. BEECH 7 N64W 7 2. BEECH 14 N49E 14  W. MILLER AUG 1883 COR. RENEWED BY SINKING 2 STONES	3. BEECH 10 N86E 41 4. MAPLE 3 N32 1/4 W 55  E.K. ROBINSON MAY 1895 SURVEY REESTABLISHED CORNER BY PROPORTIONATE MEASUREMENT & SET A 20 X 16 X 8 IN. STONE WITH A (X) CUT IN TOP.	5. APPLE 7" S 42 1/4 E 129 6. SUGAR WEST OF THREE 12" N81 1/4 W 68.51.K  T IR. SET BY UNKNOWN. FITS E.K.R. WIT. 6. SUGAR 42" N81W 45.2' CORNER USED IN SUBSEQUENT SURVETS  JOHN FERGUSON DEC. 1978. L.C.R.C. L.2 P.91 7. 37" MAPLE N84W 39.02' (SEE BACK)
--	---	---

B. Description of corner evidence found and/or method applied in restoring or reestablishing corner:

E-1 ALUM. SPIKE FD. OVER 18" BOLT OVER 2" WELL POINT WHICH FITS E.K.R. WIT.#6.  
6. 42" MAPLE N81W 45.21  
7. 42" MAPLE N77W 38.96  
11. 40" MAPLE N25W 70.14'  
12. POWER POLE S 70W 97.83'  
13. S61E 77.14 TWIN 10" APPLE 77.29'

Charlevoix Co. Surveyor  
APPROVED  
Signature: Wayne E. Boss  
Date: Nov. 13, 1996

C. Description of monument for corner and accessories established to perpetuate locating the position of the corner:

E-1 & E-13 E-1 T32N-R7W CORNER COMMON TO E-13 T33N-R7W

CHARLEVOIX CO. MON. SET.

6. 42" MAPLE N81W 45.21

7. 42" MAPLE N77W 38.96


11. 40" MAPLE N25W 70.14'

12. POWER POLE S 70W 97.83'

13. S61E 77.14 TWIN 10" APPLE 77.29'

AND IS ACCEPTED AS A CAREFUL AND FAITHFUL REESTABLISHMENT OF THE POSITION OF THE ORIGINAL CORNER.

(NEW SPIKES & TAGS SET AT EACH)

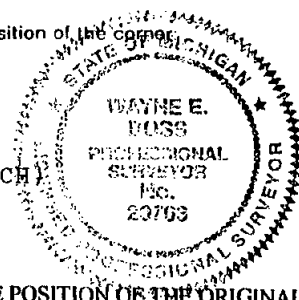

Signed by

Date

Surveyor's Michigan License No.

20703

LIBER

003

PAGE

71

(Shall have been entered in Book tower)

SURVEY &  
REMONUMENTATION

FEB 22 2001

SECTION

3615  
9.35  
cc

T32N, R7W E-1

A. con't

- 8. TELE. RISER S24W 60.9'
- 9. 15" APPLE S61E 59.45'
- 10. TELE. RISER S26E 61.80'

- N. DEYOUNG 1975 & 1983
- 7. N85W 39.00' 42" MAPLE
- 9. S60E 59.35' 10" APPLE
- 11. N36W 70.30' 40" MAPLE
- 12. S76W 97.55' POWER POLE

- L. FEINDT
- 13. S61E 77.23' TWIN 10" APPLE
- 14. S35E 45.84' CTR. SIGN POST

- J. FERGUSON 1987, L.C.R.C. L.2, P.218.
- 7. 36" MAPLE N77W 38.9'
- 9. ELM STUMP S57E 59.3'
- 11. 36" MAPLE N25W 70.2'
- 12. POWER POLE S70W 97.8'

72