

SURVEY & REMONUMENTATION

FEB 22 2001

SECTION

LAND CORNER RECORDATION CERTIFICATE

Filing Requirement of Act 74, Mich. P.A. 1970

STATE OF MICHIGAN
COUNTY OF CHARLEVOIX
RECORDED FEB 22 2001

96 DEC 11 PM 3:04

Charles M. Feindt
REGISTER OF DEEDS

For corners in
Charlevoix

(County)

Located In:

Corner Code #

1. Public Land Survey

T 32N R 7W

G-1

T 33N R 7W

G-13

T R

T R

2. Property Controlling
In Section

S T R

S T R

3. Miscellaneous
Property in Sec.

S T R

S T R

Register of Deeds Stamp & File Number

4. Lot No. , Recorded Plat

5. Private Claims

	A	B	C	D	E	F	G	H	I	J	K	L	M
2	6	5	4	3	2	1							
3													
4	7	8	9	10	11	12							
5													
6	16	17	18	15	14	13							
7													
8	19	20	21	22	23	24							
9													
10	30	29	28	27	26	25							
11													
12	31	32	33	34	35	36							
13													

I, Wayne E. Boss, in a field survey on OCTOBER 17, 19 96, do hereby certify that under requirements of P.A. 74, Michigan P.A. of 1970, the corner points mentioned in lines 1 and 2 above were in conformance with regulations and rules therefore as required in the current manual of survey instructions of the United States Department of the Interior, Bureau of Land Management or by a decree of a Court of Law and/or that the corner points mentioned in lines 3, 4 and 5 above were in conformance with the rules of the Michigan Board of Land Surveyors or by a Decree of a Court of Law; established, re-established, monumented, re-monumented, recovered, found as expressed below:

NOTE: Not more than 4 corners, all in the same town and range, may be recorded on this certificate.

A. Description of original monument and accessories and/or subsequent restoration:

G-1 GLO JUNE 1839
JOHN HODGSON
CORNER IN LAKE
SET POST 1 CHAIN WEST
A. IRONWOOD 8 S39W 20
B. CEDAR 9 N51W 14

AUG. 1944 R.F. SLOAN
REFERENCED CORNER
LOCATION TO A MON.
120 FT. WEST ON N. SEC. LINE
AND TO A MON. 120 FT.
SOUTH ON E. SEC. LINE, SEC. 4
CORNER LOCATION NO LONGER
UNDER WATER BECAUSE OF
LOWERED LAKE LEVEL.

M.FEINDT SET IR.
AT CORNER (G-1)
FOR CHALET VILLAGE
SUBDIVISION L.2
PAGE 292. MAR. 1976
1. WEST 120.0 CONC. MON.
2. WEST 10.0 CONC. MON.
3. SOUTH 120.0 1/2" IRON

B. Description of corner evidence found and/or method applied in restoring or reestablishing corner:

G-1 NO CORNER FD. AT LOCATION PER CHALET VILLAGE SUB. PLAT MONS.
WERE FOUND WHICH REFERENCE SEC. CORNER LOCATION. CORNER
RESET BASED ON MONUMENTS.
1. WEST 120.0' CONC. MON.
2. WEST 10.0' CONC. MON.


Charlevoix Co. Surveyor
APPROVED
Signature Mary C. Feindt
Date: Nov. 13, 1996

Description of monument for corner and accessories established to perpetuate locating the position of the corner:

G-1 T32N-R7W CORNER COMMON TO G-13 T33N-R7W
CHARLEVOIX COUNTY MON. SET

1. WEST 120.0' CONC. MON.
2. WEST 10.0' CONC. MON.
3. S30W 28.95' N.E. COR. HOUSE
4. S60W 43.80' N.W. COR. HOUSE
5. EAST 21' LAKE CHARLEVOIX
6. NORTH 10' LAKE CHARLEVOIX

THIS POSITION NOT ESTABLISHED BY ORIGINAL GOV'T SURVEYORS. THIS MONUMENT IS ACCEPTED AS THE BEST AVAILABLE EVIDENCE OF THE POSITION OF THE CORNER.

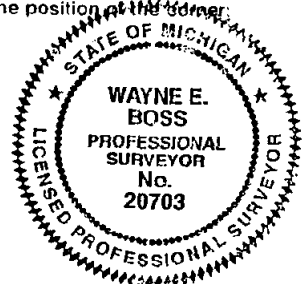

igned by [Signature] Date 11/29/96
urveyor's Michigan License No. 20703 LIBER 003 PAGE 79

This should have been entered