

SURVEY &
REMONUMENTATION

FEB 04 1999

STATE OF MICHIGAN
COUNTY OF CHARLEVOIX
RECORDED

98 DEC 21 PM 3:38

SECTION

LAND CORNER RECORDATION CERTIFICATE
Filing Requirement of Act 74, Mich. P.A. 1970

Charles R. Ranger
REGISTER OF DEEDS

For corners in

CHARLEVOIX Located In: Corner Code #
(County)

1. Public Land Survey T.33NR 8W M-5
T R
T R
T R
2. Property Controlling S T R
in Section S T R
3. Miscellaneous S T R
Property in Sec. S T R

Register of Deeds Stamp & File Number

4. Lot No. , Recorded Plat
5. Private Claims

I, ARTHUR R. RANGER, in a field survey on NOV. 11, 1998
do hereby state that under requirements of P.A. 74, Michigan P.A. of 1970, the corner points mentioned in
lines 1 and 2 above were in conformance with regulations and rules therefore as required in the current manual
of survey instructions of the United States Department of the Interior, Bureau of Land Management or by a
decree of a Court of Law and for that the corner points mentioned in lines 3, 4 and 5 above were in
conformance with the rules of the Michigan Board of Land Surveyors or by a Decree of a Court of Law;
established, re-established, monumented, recovered, found as expressed below:

NOTE: Not more than 2 corners, all in the same town and range, may be recorded
on this certificate.

	A	B	C	D	E	F	G	H	I	J	K	L	M
1													
2		6		5		4		3		2		1	
3													
4		7		8		9		10		11		12	
5													
6		18		17		16		15		14		13	
7													
8		19		20		21		22		23		24	
9													
10		30		29		28		27		26		25	
11													
12		31		32		33		34		35		36	
13													

A. Description of original monument and accessories and/or subsequent restoration:
M-5 corner common to Sec. 12 & 13 T.33N., R.8W. & Sec. 7 & 18, T.33N., R.7W.

1840- John Mullett set post corner to Sec.'s 12 & 13, and witnessed: Cedar 10" S48°E 33lks; Cedar 12" N17°W 17 lks.
1880- Joseph R. Dixon used the corner in a survey in Sec. 13--no witnesses
18__- Joseph R. Dixon used the corner in a survey in Sec. 18--witness: 8" Cedar West 11lks.
1883- William Miller used the corner in his survey of Sec. 12--no witnesses.
1973- Mary Feindt found a 2" iron pipe in her survey --- no witnesses.
19__- The corner is being used by surveyors in the area.

B. Description of corner evidence found and/or method applied in restoring or reestablishing corner:
M-5 corner common to Sec. 12 & 13 T.33N., R.8W. & Sec. 7 & 18, T.33N., R.7W.

1998- Arthur R. Ranger found the 2" iron pipe at a N.&S. / E.&W. fence intersection.
Fits old county survey distance to the North quite well.
M-5 to M-4 = 2631.51' and M-5 to M-6 = 2659.89'

C. Description of monument for corner and accessories established to perpetuate locating the position of the corner:
M-5 corner common to Sec. 12 & 13 T.33N., R.8W. & Sec. 7 & 18, T.33N., R.7W.


(Set a Charlevoix County Cap over the 2" iron pipe)

Witnesses:
9" Cedar S25°W 6.43'
14" Cedar N04°E 12.08'
8" Cedar S73°W 9.08'
13" Black Ash N70°W 16.42'

AND IS ACCEPTED AS A CAREFUL AND FAITHFUL PERPETUATION OF THE POSITION OF THE ORIGINAL CORNER.

Signed by Arthur R. Ranger
Surveyor's Michigan License No. 31601

Date 12/16/98

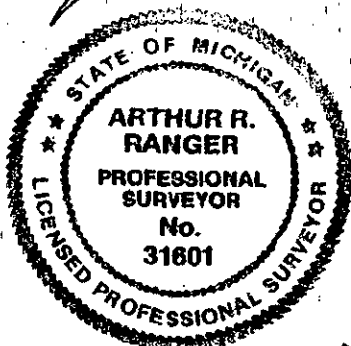

FORM APPROVED BY MICHIGAN STATE BOARD OF PROFESSIONAL SURVEYORS, JAN. 28, 1971
REVISED MAY 14, 1975
REVISED JAN., 1983
REVISED OCT., 1995

Charlevoix Co. Surveyor
APPROVED
Mary C. Feindt
Date: Dec 17, 1998