

# LAND CORNER RECORDATION CERTIFICATE

FILING REQUIREMENT OF ACT 74, MICH. P.A.1970

FOR CORNERS OF -:	LOCATED IN -:	CORNER CODE NUMBER
1. PUBLIC LAND SURVEY _____ T. <u>33</u> N. <u>9</u> W.		I-11, J-10
2. PROPERTY CONTROLLING IN SECTION _____ T. _____ N. S., R. _____ E. W.		
3. MISCELLANEOUS PROPERTY IN SECTION _____ T. _____ N. S., R. _____ E. W.		
4. LOT NO. _____, RECORDED PLAT _____		
5. PRIVATE CLAIMS _____		

REGISTER OF DEEDS STAMP AND  
FILING NUMBER

I, CARL F. ROSER, do hereby certify that under requirements of P.A. 74, Michigan P.A. of 1970, the corner points mentioned in lines 1 and 2 above were, in a field survey on FEBRUARY 27, 1986, established, re-established, monumented, re-monumented, recovered or restored as expressed below and in conformance with regulations and rules therefore as required in the current manual of survey instructions of the United States Department of the Interior, Bureau of Land Management or by a decree of a court of law. Furthermore, that the corner points mentioned in lines 3, 4 and 5 above were, in a field survey on \_\_\_\_\_, 19\_\_\_\_, found, recovered, restored, established or re-established as expressed below and in conformance with the rules of the Michigan State Board of Registration for Land Surveyors or, by a Decree of a Court of law:

A. Description of original monument and accessories and/or subsequent restoration:  
B. (CONTINUED)

J-10 CED POSTS. SINCE CONTROLLING GOVT. COR'S IN THIS GENERAL AREA ARE GENERALLY BEST EVIDENCE BASED ON OCCUPATION ONLY, & BECAUSE THE OLD FENCE COR IS BELIEVED TO BE A RESULT OF D.C. NETTELTON'S 1915 SURVEY THIS AREA (HIS NOTES ARE PART OF CHARLEVOIX ABSTRACT & ENGR. CO RECORDS); THE OLD FENCE COR (NAIL IN 4" CED STUMP) WAS ACCEPTED AS THE CTR OF SEC 26. WE WERE ABLE TO CUT OFF THE 4" CED STUMP & DRIVE A 5/8" X 34" REROD THROUGH THE ROTTED ROOTS.

B. Description of corner evidence found and/or method applied in restoring or re-establishing corner:

I-11 FD 3/4" PIPE FOR SW COR OF SEC 26; IN LINE WITH OLD FENCE'S TO EAST AND SOUTH (W-W & 3 B-W ON CED. POSTS) & FENCE REMAINS WEST (OLD CED POSTS-ALL ON GROUND). FITS 1980 WITS BY RLS, WAYNE BOSS. I BELIEVE THIS 3/4" PIPE WAS SET BY R.L.S. MARY FEINDT AT OLD COR FENCE POST IN 1964 (COR FN POST NOW DOWN). DISTANCE WEST TO EDGE OF WATER (L.MICH-SUMMER 1982) IS 631'±. D.C. NETTELTON, OCT. 1915 HAD 10 CHAINS (660' TO NEAREST CH); HIS NOTE'S IN THIS AREA BEING PART OF CHARLEVOIX ABSTRACT & ENGR CO'S RECORDS.

J-10 FD NAIL IN 4" CED. STUMP AS SET & WIT BY R.L.S.-NICK DEYOUNG FOR CTR OF SEC 26 (SEE HIS 1978 CERT SURVEY OF NE 1/4 OF SW 1/4 OF S-26). COR IS @ OLD COR FN POST (DOWN), FN'S N-S-E-W. FN'S N-S-W ARE W-W WITH 1-STRAND B-W ON CED POSTS; FN EAST IS B-W ONLY ON

(C) Description of monument for corner and accessories established to perpetuate locating the position of the corner:

I-11

FD 3/4" X 40" PIPE. REPLACED W/DNR MON & SET CEDAR W/LOC TAG.  
 \* 6" TRIPLE W. BIRCH N20°W 25.00  
 \* 12" CEDAR S88°E 5.14  
 3" CEDAR S50°E 15.39  
 \* 6" CEDAR S80°W 11.83  
 N-S TRAIL ROAD WEST 400'±

J-10

FD/NAIL IN 4" CEDAR STP. REPLACED W/5/8" X 34" REROD W/RLS CAP & SET CEDAR POST W/LOC TAG.  
 \* 5" CEDAR S84°E 12.5  
 \* 4" W.BIRCH N04°W 11.9  
 5" CEDAR N42°W 14.9  
 \* 9" CEDAR N86°W 9.3

\*\* = DE YOUNG'S N.B.T.'S

\*\*=PREVIOUS SURVEY UNIT

SIGNED BY Carl F. Roser 03-26-86 DATE \_\_\_\_\_

SURVEYOR'S MICHIGAN REGISTRATION NO. 12028

FOR STATE AND UNITED STATES AGENCIES:


SIGNED BY \_\_\_\_\_ DATE \_\_\_\_\_

CHIEF OF SURVEY PARTY

APPROVED AND SIGNED BY \_\_\_\_\_ DATE \_\_\_\_\_

MICHIGAN REGISTERED LAND SURVEYOR

SURVEYOR'S MICHIGAN REGISTRATION NO. \_\_\_\_\_

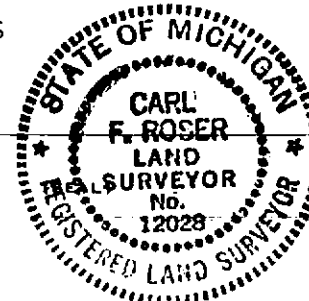

(SEAL)  
CHARLEVOIX COUNTY  
NORWOOD TOWNSHIP