

LAND CORNER RECORDATION CERTIFICATE
FILING REQUIREMENT OF ACT 74, MICH. P.A.1970

FOR CORNERS OF--	LOCATED IN--	CORNER CODE NUMBER
1. PUBLIC LAND SURVEY	T. 33 N. R. 9 E. W.	K-7, J-7
2. PROPERTY CONTROLLING IN SECTION	T. S. R. E. W.	
3. MISCELLANEOUS PROPERTY IN SECTION	23 T. 33 N. R. 9 E. W.	#1590'-W OF J-7
4. LOT NO.	RECORDED PLAT	
5. PRIVATE CLAIMS		

REGISTER OF DEEDS STAMP AND
FILING NUMBER

I, CARL ROSER, do hereby certify that under requirements of P.A. 74, Michigan P.A. of 1970, the corner points mentioned in lines 1 and 2 above were, in a field survey on FEBRUARY 24, 1986, established, re-established, monumented, re-monumented, recovered or restored as expressed below and in conformance with regulations and rules therefore as required in the current manual of survey instructions of the United States Department of the Interior, Bureau of Land Management or by a decree of a court of law. Furthermore, that the corner points mentioned in lines 3, 4 and 5 above were, in a field survey on FEBRUARY 24, 1986, found, recovered, restored, established or re-established as expressed below and in conformance with the rules of the Michigan State Board of Registration for Land Surveyors or, by a Decree of a Court of law:

XX
C. CONTINUED:

;;

SET DNR MON FROM ONE U.S.B.T. STUMP REMAINS &
SET CEDAR POST.

4" W. Pine	N35°W	13.7
U.S. PINE STP REMAINS	N40°E	37.0
7" MAPLE	N80°E	18.7
6" CEDAR	S16°E	14.8

B. Description of corner evidence found and/or method applied in restoring or re-establishing corner:

- K-7 RESTORED NE COR OF SEC.23 AT OLD LARGE COR FN POST, FN REMAINS N-S-E-. FITS VERY REASONABLY E.A. ROBINSON'S DISTANCE EAST 1/2 MILE, SOUTH 1/2 MILE & U.S. (G.L.O.) DISTANCE WEST TO RECOVERED U.S.M.C. IRREGULAR N-S TRAIL INTO SWAMP (WET) IS 33± WEST.
- J-7 RE-ESTABLISHED N 1/4 COR OF SEC.23 AT SINGLE PROPORTIONATE MEASURE TO 1841 U.S. (G.L.O.) SURVEY BETWEEN RECOVERED U.S.M.C. TO WEST AND SEC. COR TO EAST.
- ;; RESTORED U.S. (1841 G.L.O.) MEANDER COR FROM U.S.B.T. PINE STUMP REMAINS SHOWING GOOD LOWER FACE (PINE 10", N40°E, 37'). COR FALLS AT TOP OF N-S RIDGE, AT WOODED EDGE AS IT DROPS OFF TO BEACH TO LAKE MI. WATER'S EDGE (L.MI) WAS 120'± WEST IN SUMMER 1983. N-S FOOT TRAIL IS 65'± EAST.

C. Description of monument for corner and accessories established to perpetuate locating the position of the corner:

K-7

J-7

SET DNR MON AT OLD LARGE COR FN POST &
SET CED POST.

SET DNR MON & CED POST.

14" CEDAR	N70°E	24.3
13" W. BIRCH	S20°E	9.7
8" CEDAR	N88°W	78.7
4" CEDAR	N70°W	28.5

12" CEDAR	N40°W	15.5
12" TRIPLE W. BIRCH	S05°W	13.3
7" CEDAR	S45°E	11.6
4" MAPLE	S30°W	9.0

SIGNED BY Carl F. Roser 03-26-86 DATE

SURVEYOR'S MICHIGAN REGISTRATION NO. 12028


FOR STATE AND UNITED STATES AGENCIES:

SIGNED BY _____ DATE _____

CHIEF OF SURVEY PARTY

APPROVED AND SIGNED BY _____ DATE _____

MICHIGAN REGISTERED LAND SURVEYOR

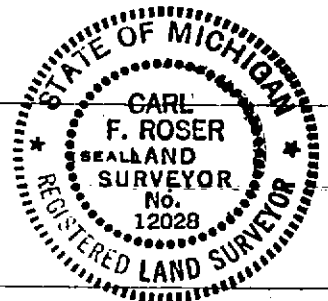

CHARLEVOIX COUNTY
NORWOOD TOWNSHIP

SURVEYOR'S MICHIGAN REGISTRATION NO. _____