

LAND CORNER RECORDATION CERTIFICATE

Filing Requirement of Act 74, Mich. PA 1970

For Corners In:  
Cheboygan  
(County)

Located In


Corner Code #

1. Public Land Survey T 33N R 2W K-5  
T 33N R 2W K-7
2. Property Controlling  
in Section S T R  
S T R
3. Miscellaneous  
Property in Section S T R  
S T R
4. Lot No: Recorded Plat:
5. Private Claims:

Register of Deeds Stamp & File Number

I, Carl T. Kuiskila, in a field survey on July 14, 2010 do hereby state that under requirements of PA 74, Michigan PA of 1970, the corner points mentioned in lines 1 and 2 above were in conformance with regulations and rules therefore as required in the current manual of survey instructions of the United States Department of the Interior, Bureau of Land Management or by a decree of a Court of Law and/or that the corner points mentioned in lines 3, 4 and 5 above were in conformance with the rules of the Michigan Board of Land Surveyors or by a Decree of a Court of Law, established, re-established, monumented, recovered, found as expressed below:

NOTE: Not more than 2 corners, all in the same town and range, may be recorded on this certificate.

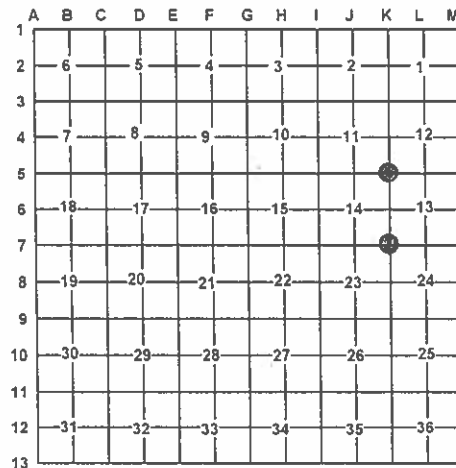

A. Description of original monument and accessories and/or subsequent restoration:

K-5 – Section Cor. comm. to sec.'s 11,12,13,14, T33N,R2W

1850 – GLO – William Burt – Set Hemlock post corner of sec.'s 11-12-13 & 14.  
W. Pine 24 S38°W 86 links  
W. Pine 20 N79°E 1.32 chains

1956 – Survey Map – Thomas F. Schweigert, P.S.#6525 – Shows distances going North and East from corner with fence line going East. Found evidence of O.B.T. 10° W. Pine N09°W 45.5'  
13° R. Pine S64°E 89.1'

K-7 – Section Cor. comm. to sec.'s 13,14,23,24, T33N,R2W

1850 – GLO – William Burt – Set Hemlock post. Corner sec.'s 13,14,23&24.  
W. Pine 30 N58°W 23 links  
Beech 8 S78°E 82 links

1972 – Cert. of Survey – L.333, p.299 – Delmer E. Porter, P.S.#15410 – Set mon. NW cor. sec. 24 . 10° Norway N76°E 66.52'; 8° Norway S32°E 60.80'; 18° Norway N33°W 82.66'

1981 – Unrecorded Cert. of Survey – Richard C. Dunn, P.S.#12020 – Shows SE cor. section 14 concrete monument.

2000 – Unrecorded Survey – Wade Trim Inc. – Brian K. Fullford, P.S.#41099 – SE cor. sec. 14 found conc. mon. 10° Birch N57°W 39.88'; 8° R.Pine S33°E 45.14'; 5° W.Pine S13°W 35.41'; 14° R.Pine S59°E 36.10'

B. Description of corner evidence found and/or method applies in restoring or re-establishing corner:

K-5 – Section Cor. comm. to sec.'s 11,12,13,14, T33N,R2W

Found concrete monument at intersection of fence lines running East, West and South. Found both of Schweigert's witnesses from 1956 Survey Map. Stump was all that was remaining of witness to NW. Red Pine to SE was in good condition. Accepted found concrete monument as a careful and faithful perpetuation of the position of the original corner. Added ½" plastic P.S.#33981 to rebar in concrete monument. Found no other evidence to dispute the location for the corner.

K-7 – Section Cor. comm. to sec.'s 13,14,23,24, T33N,R2W

Found 4" dia. concrete monument with ½" bar in center at the East end of a gate on a N-S two-track per L.C.R.C., L.333, p.299. The corner measures +/- 225' short of GLO distance to the North from K5 which is a faithful perpetuation of the position of the original corner. Although the the next two miles South of K7 measure reasonable to record, the last mile along the West side of section 36 measures +/- 250' long. Searched extensively for remains of GLO witnesses, but could find no other evidence to dispute the location for the corner. Added ½" plastic cap#33981 to bar on monument. Accepted found conc. mon. as the best available evidence for the position of the original corner.

C. Description of monument for corner and accessories established to perpetuate locating the position of the corner:

K-5 – Section Cor. comm. to sec.'s 11,12,13,14, T33N,R2W

4" dia. concrete monument w/ ½" rebar and cap#33981

Witnesses:

N42°E 55.37' to set N&T on SE side 14" R. Pine  
\*S70°E 89.35' to set N&T on N side 24" R. Pine  
S56°W 52.04' to set N&T on SE side 20" W. Pine  
N21°W 58.95' to set N&T on NE side 15" W. Pine  
Set Blue Carsonite Post w/ location tag on S. edge of monument.

\* Previous witness of record.

K-7 – Section Cor. comm. to sec.'s 13,14,23,24, T33N,R2W

4" dia. concrete monument w/ ½" bar and plastic P.S. cap #33981

Witnesses:

N25°E 25.31' to set N&T on W side 6" W. Pine  
\*S48°E 36.77' to set N&T on S side 15" R. Pine  
\*S18°W 45.19' to set N&T on NW side 10" R. Pine  
N72°W 35.90' to set N&T on S side 6" W. Pine  
West 10' to C/L N-S two-track road  
Set Blue Carsonite Post w/ location tag 1' North

\* Previous witness of record.

Signed by:

Carl T. Kuiskila

Surveyor's Michigan License No.:

33981

Date:

8-17-11

