

1998 CHEBOYGAN COUNTY, STATE OF MICHIGAN REMONUMENTATION

LAND CORNER RECORDATION CERTIFICATE  
Filing Requirement of Act 74, Mich. P.A. 1970

SECTION

For corners in

Cheboygan  
(County)

Located In:

Corner Code #

Forest Township  
1. Public Land Survey

T34NR 1E	B-3
T R	
T R	
T R	
S T R	
S T R	
S T R	
S T R	

2. Property Controlling  
in Section3. Miscellaneous  
Property in Sec.RECEIVED FOR RECORD 12-7-98  
at 9:28 O'Clock A M

Joanne Spray

CLERK/REGISTER  
CHEBOYGAN COUNTY, MICHIGAN

Register of Deeds Stamp &amp; File Number

4. Lot No. \_\_\_\_\_, Recorded Plat \_\_\_\_\_  
5. Private Claims \_\_\_\_\_

I, Ronald Bischer, in a field survey on 7-13, 1998 do hereby state that under requirements of P.A. 74, Michigan P.A. of 1970, the corner points mentioned in lines 1 and 2 above were in conformance with regulations and rules therefore as required in the current manual of survey instructions of the United States Department of the Interior, Bureau of Land Management or by a decree of a Court of Law and /or that the corner points mentioned in lines 3, 4 and 5 above were in conformance with the rules of the Michigan Board of Land Surveyors or by a Decree of a Court of Law; established, re-established, monumented, recovered, found as expressed below:

NOTE: Not more than 2 corners, all in the same town and range, may be recorded on this certificate.

	A	B	C	D	E	F	G	H	I	J	K	L	M
1													
2		6		5		4		3		2		1	
3													
4		7		8		9		10		11		12	
5													
6		18		17		16		15		14		13	
7													
8		19		20		21		22		23		24	
9													
10		30		29		28		27		26		25	
11													
12		31		32		33		34		35		36	
13													


A. Description of original monument and accessories and/or subsequent restoration:

B-3  
1855 GLO Notes  
George Cannon (Resurvey)  
SEt wood post  
N23°W 171ks 12" Hemlock  
S07°W 131ks 13" Hemlock

July 30, 1971  
Delmer Porter #15410  
Found 1" Pipe  
N45°E 44.72' 22" Elm  
South 32.23' Corner fence post

B. Description of corner evidence found and/or method applied in restoring or reestablishing corner:


B-3  
Found 1" pipe with two witnesses  
replaced with 5/8" rod and remon cap

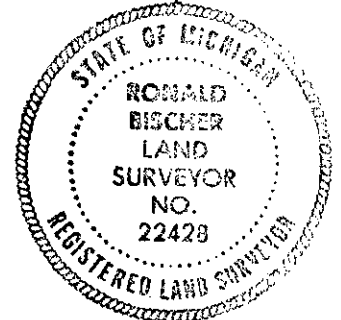

C. Description of monument for corner and accessories established to perpetuate locating the position of the corner:

B-3  
5/8" Rod and Remon cap  
S08°W 32.40' Fence corner (O.W.)  
S45°E 39.67' 5" Apple  
S47°W 36.10' 4" Elm  
S80°W 108.52' P. Pole

LIBER 011 PAGE 93

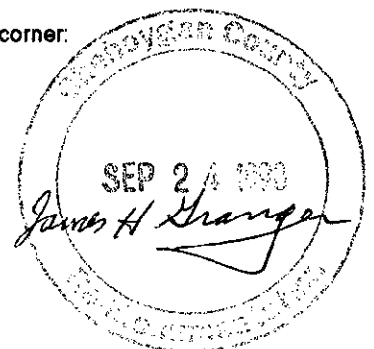

Signed by Ronald R. Bischer  
Surveyor's Michigan License No. 22428

Date Sept. 28, 1998