

1998 CHEBOYGAN COUNTY, STATE OF MICHIGAN REMONUMENTATION  
MAR 2 1999

LAND CORNER RECORDATION CERTIFICATE  
Filing Requirement of Act 74, Mich. P.A. 1970

SECTION

For corners in

Cheboygan

(County)

Forest Township

1. Public Land Survey

Waverly Township

Located in:

Corner Code #

T34NR 1E  
T35NR 1E  
T R  
T R  
T R  
S T R  
S T R  
S T R  
S T R

C-1  
C-13

RECEIVED FOR RECORD 12-7-98  
at 9:29 O'Clock A. M

Joanne Spray

CLERK/REGISTER  
CHEBOYGAN COUNTY, MICHIGAN

Register of Deeds Stamp & File Number

4. Lot No. , Recorded Plat  
5. Private Claims

I, Ronald Bischer, in a field survey on 7-13, 19 98 do hereby state that under requirements of P.A. 74, Michigan P.A. of 1970, the corner points mentioned in lines 1 and 2 above were in conformance with regulations and rules therefore as required in the current manual of survey instructions of the United States Department of the Interior, Bureau of Land Management or by a decree of a Court of Law and /or that the corner points mentioned in lines 3, 4 and 5 above were in conformance with the rules of the Michigan Board of Land Surveyors or by a Decree of a Court of Law, established, re-established, monumented, recovered, found as expressed below:

NOTE: Not more than 2 corners, all in the same town and range, may be recorded on this certificate.


	A	B	C	D	E	F	G	H	I	J	K	L	M
1													
2													
A. Description of original monument and accessories and/or subsequent restoration:

C-1  
1840 John Hodgson

1855 GLO Notes by George Cannon (Resurvey)  
set wood post  
S32°E 15 lks 9" Cedar  
S50°W 25 lks 8" Cedar  
N40°W 10.5 lks 12" Spruce  
N52°E 53 lks 10" Spruce

June 7, 1972  
Delmer Porter #15410  
Found 3" Pipe at intersections of road  
set 7 witnesses  
Oct. 9, 1973 Delmer Porter #15410  
found 3" Pipe  
found same witnesses  
June 23, 1976 Delmer Porter #15410  
found 3" Pipe same witnesses as above

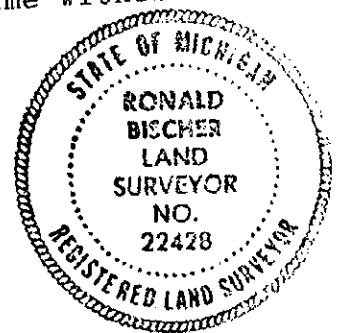


B. Description of corner evidence found and/or method applied in restoring or reestablishing corner:  
C-1  
Found 3" Pipe  
replaced with 5/8" rod and remon cap

C. Description of monument for corner and accessories established to perpetuate locating the position of the corner:

C-1  
5/8" Rod and Remon cap  
S54°W 45.41' P. Pole  
N39°W 51.88' P. Pole  
N52°E 48.38' P. Pole  
S45°E 42.97' Fence corner

LIBER 011 PAGE 94

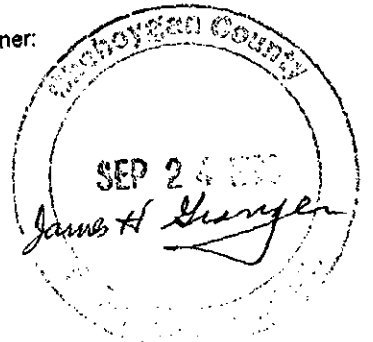

Signed by Ronald B. Bischer  
Surveyor's Michigan License No. 22428

Date Sept. 28, 1998