

REV. 4-1-1999

1998 CHEBOYGAN COUNTY, STATE OF MICHIGAN REMONUMENTATION

SECTION  
7

LAND CORNER RECORDATION CERTIFICATE  
Filing Requirement of Act 74, Mich. P.A. 1970

For corners in

Cheboygan  
(County)

Located In:

Corner Code #

Forest Township

1. Public Land Survey

T 34 N R 1 E E-2

T R

T R

T R

2. Property Controlling  
in Section

S T R

S T R

3. Miscellaneous  
Property in Sec.

S T R

S T R

RECEIVED FOR RECORD 12-7-98  
at 9:35 O'Clock A M

*Joanne Spray*

CLERK/REGISTER  
CHEBOYGAN COUNTY, MICHIGAN

Register of Deeds Stamp & File Number

4. Lot No. , Recorded Plat

5. Private Claims

I, Ronald Bischer, in a field survey on 7-15, 1998 do hereby state that under requirements of P.A. 74, Michigan P.A. of 1970, the corner points mentioned in lines 1 and 2 above were in conformance with regulations and rules therefore as required in the current manual of survey instructions of the United States Department of the Interior, Bureau of Land Management or by a decree of a Court of Law and /or that the corner points mentioned in lines 3, 4 and 5 above were in conformance with the rules of the Michigan Board of Land Surveyors or by a Decree of a Court of Law; established, re-established, monumented, recovered, found as expressed below:

NOTE: Not more than 2 corners, all in the same town and range, may be recorded on this certificate.

	A	B	C	D	E	F	G	H	I	J	K	L	M
1													
2	6			5		4		3		2		1	
3													
4	7		8			9		10		11		12	
5													
6	18		17		16		15		14		13		
7													
8	19		20		21		22		23		24		
9													
10	30		29		28		27		26		25		
11													
12	31		32		33		34		35		36		
13													


A. Description of original monument and accessories and/or subsequent restoration:

E-2  
1855 GLO Notes George Cannon (Resurvey)  
Set wood post  
S68° E 16 lks 7" W. Birch  
East 7 lks 6" Aspen  
June 7, 1972 Delmer Porter #15410  
Set 1/2" rod and cap at intersection  
of 4 fences and 3 witnesses

Sept. 13, 1972 Delmer Porter #15410  
Found 1/2" rod and cap at fence corner  
3 witnesses  
Sept. 23, 1983 Delmer Porter #15410  
found 1/2" rod and cap and 3 witnesses


B. Description of corner evidence found and/or method applied in restoring or reestablishing corner:

E-2  
Found 1/2" rod and cap  
replaced with 5/8" rod and remon cap

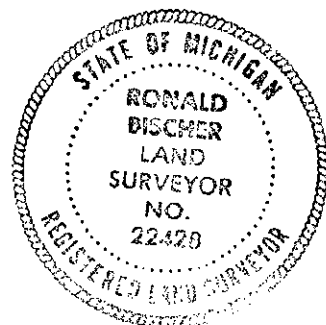

C. Description of monument for corner and accessories established to perpetuate locating the position of the corner:

E-2  
5/8" rod and remon cap  
S64° E 7.12' 6" Aspen  
N55° W 5.70' 13" Aspen  
S28° W 26.13' 4" Aspen  
S18° E 23.00' 6" Aspen

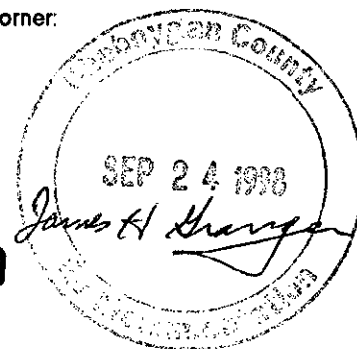

LIBER 011 PAGE 100

Signed by Ronald R. Bischer  
Surveyor's Michigan License No. 22428

Date Sept. 28, 1998