

MICHIGAN
DEPARTMENT OF CONSERVATION
FORESTRY DIVISION

LAND CORNER RECORD

T. 34 N.R. 1 E


Cheboygan COUNTY

DESCRIPTION OF CORNER 1/4 corner common to Sections 32 and 33

CORNER MONUMENT Set 1" pipe with 4" aluminum cap

DATE MONUMENT PLACED AND WITNESSED March 31, 1966

WITNESSES TO CORNER.....

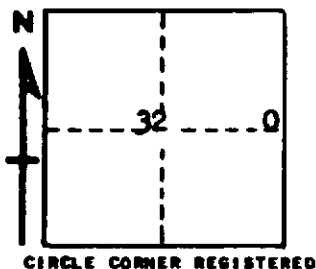

8" W. Pine N 68 W 48.6

*12" W. Pine stump N 81 E 12.0

*USBT stump

AND Found stain and wood of old post

CIRCLE CORNER REGISTERED

DESCRIPTION IN DETAIL AS TO HOW CORNER WAS LOCATED AND IDENTIFIED OR RESTORED.

This corner was found while making a survey in this township. Found evidence of post bottom in position prescribed by NE government BT stump which is in place with evidence of both upper and lower faces.

SURVEYOR'S SEAL

SIGNED Kenneth J. Ostling DATE April 14, 1966
REGISTERED LAND SURVEYOR #110068