

SURVEY &
REMONUMENTATION

MAY 03 1995

CHEBOYGAN COUNTY REMONUMENTATION
LAND CORNER RECORDATION CERTIFICATE
Filing Requirement of Act 74, Mich. P.A. 1970

For corners in

COMMISSION

Cheboygan

(County)

Located In:

Corner Code #

1. Public Land Survey

T 34N R 1W

A-8

T R

T R

T R

2. Property Controlling
in Section

S T R

S T R

3. Miscellaneous
Property in Sec.

S T R

S T R

4. Lot No. , Recorded Plat

5. Private Claims

RECEIVED
FOR RECORD

94 DEC 28 PM 4:27

James H. Granger

CLERK/REGISTER
CHEBOYGAN COUNTY, MICHIGAN

Register of Deeds Stamp & File Number

	A	B	C	D	E	F	G	H	I	J	K	L	M
2	6		5		4		3		2		1		
3													
4	7		8		9		10		11		12		
5													
6	18		17		16		15		14		13		
7													
8	19		20		21		22		23		24		
9													
10	30		29		28		27		26		25		
11													
12	31		32		33		34		35		36		
13													

I, James H. Granger, in a field survey on December 5, 1994, do hereby certify that under requirements of P.A. 74, Michigan P.A. of 1970, the corner points mentioned in lines 1 and 2 above were in conformance with regulations and rules therefore as required in the current manual of survey instructions of the United States Department of the Interior, Bureau of Land Management or by a decree of a Court of Law and/or that the corner points mentioned in lines 3, 4 and 5 above were in conformance with the rules of the Michigan Board of Land Surveyors or by a Decree of a Court of Law; established, re-established, monumented, re-monumented, recovered, found as expressed below:

NOTE: Not more than 4 corners, all in the same town and range, may be recorded on this certificate.

A. Description of original monument and accessories and/or subsequent restoration:


1840 Original Survey Set wood post 10" Beech N63°W 15 lks, 10" Sugar S32°E 22 lks
John Mullett

3. Description of corner evidence found and/or method applied in restoring or reestablishing corner:

Ed No evidence. Placed 5/8" rebar w/aluminum cap by single proportionate measurement between the NW and SW section corners.

LIBER 010 PAGE 87


Marvin A. Rose

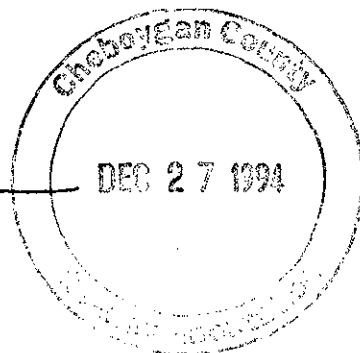

2. Description of monument for corner and accessories established to perpetuate locating the position of the corner:

5/8" rebar w/aluminum cap

Steel fence post N30°E 0.5'
Steel fence post S76°E 7.86'
Steel fence post N87°W 7.65'
4" Spruce S28°E 30.12'

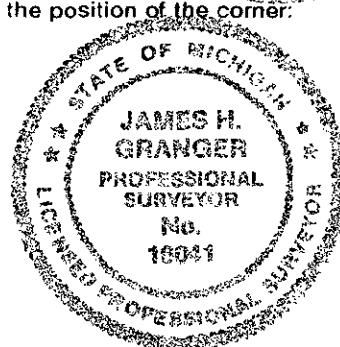

igned by James H. Granger

Date 12-9-94

urveyor's Michigan License No. 16041