

MICHIGAN  
DEPARTMENT OF CONSERVATION  
FORESTRY DIVISION

LAND CORNER RECORD

T. 34 N. R. 1 W


Cheboygan COUNTY

DESCRIPTION OF CORNER Section corner common to sections 10-11-14-15

CORNER MONUMENT Drove 1" x 30" pipe

DATE MONUMENT PLACED AND WITNESSED 10-20-66

WITNESSES TO CORNER.....

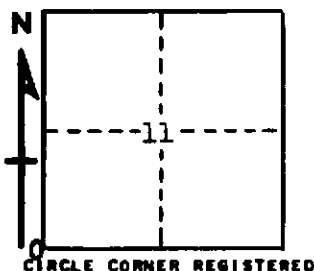

CIRCLE CORNER REGISTERED

6" Maple S 27 E 28.2'

AND

DESCRIPTION IN DETAIL AS TO HOW CORNER WAS LOCATED AND IDENTIFIED OR RESTORED.

This corner was set by double proportionate measurement while making a survey in this township. Could locate nothing for a previous corner. This point falls about 6' south of roadcenterline and about 6' east of fence line north, but fits fences of occupation west and east.

SURVEYOR'S SEAL

SIGNED Kenneth J. Ostling DATE Nov. 18, 1966  
REGISTERED LAND SURVEYOR #10068