

MICHIGAN  
DEPARTMENT OF CONSERVATION  
FORESTRY DIVISION

LAND CORNER RECORD

T. 34 N.R. 1 W


Cheboygan COUNTY

DESCRIPTION OF CORNER 1/4 corner common to sections 19 - 30

CORNER MONUMENT Set 1" pipe with 4" aluminum cap

DATE MONUMENT PLACED AND WITNESSED 9-19-66

WITNESSES TO CORNER.....

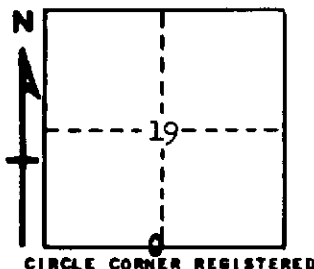

8" Balsam N 11 E 21.6'

5" W. Birch N 52 W 10.9'

Old NBT - Pine Stp. N 39 W 27.8'

AND

DESCRIPTION IN DETAIL AS TO HOW CORNER WAS LOCATED AND IDENTIFIED OR RESTORED.

This corner was found while making a survey in this township. Found pipe in place as established by Marcus Schaaf, RLS, in previous survey of this township. Old fence lines running north and south.

SURVEYOR'S SEAL

SIGNED *Kenneth J. Petting* DATE 11-18-66  
REGISTERED LAND SURVEYOR #10068