

LAND CORNER RECORDATION CERTIFICATE

Filing Requirement of Act 74, Mich. PA 1970

For Corners In:
Cheboygan
(County)

Located In

Corner Code #

1. Public Land Survey	T	34N	R	3W	E-2
	T		R		
2. Property Controlling in Section	S	T		R	
	S	T		R	
3. Miscellaneous Property in Section	S	T		R	
	S	T		R	


4. Lot No: _____ Recorded Plat: _____

5. Private Claims: _____

I, Carl T. Kiiskila, in a field survey on March 12, 2008 do hereby state that under requirements of PA 74, Michigan PA of 1970, the corner points mentioned in lines 1 and 2 above were in conformance with regulations and rules therefore as required in the current manual of survey instructions of the United States Department of the Interior, Bureau of Land Management or by a decree of a Court of Law and/or that the corner points mentioned in lines 3, 4 and 5 above were in conformance with the rules of the Michigan Board of Land Surveyors or by a Decree of a Court of Law; established, re-established, monumented, recovered, found as expressed below:

NOTE: Not more than 2 corners, all in the same town and range, may be recorded on this certificate.

Register of Deeds Stamp & File Number

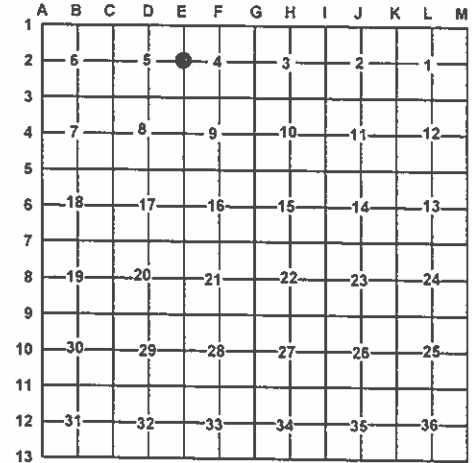

A. Description of original monument and accessories and/or subsequent restoration:

E-2 G.L.O. C.W. Cathcart 1840, Set quarter section post.

Wit: Birch 8" N45°W 10 links
Birch 6" N70°E 14 links

1998 Richard C. Dunn P.S. #12020 found the DNR Monument 30' West of the proper location witnesses by K.J. Ostling he reset the monument.

1961 K.J. Ostling found 1/2" pipe in line with old road North and midway between lane fences set DNR Monument.

Wits. 7" Elm N 18°W 11.6'
4" Ironwood N88°E 20.6'

2002 Brian Fullford P.S. #41099 found the DNR Monument out of position he also found 1/2" pipe fitting one of K.J. Ostling's witnesses.

Liber A , Page 237 D. DeLaMater recorded corner by K.J. Ostling same witnesses as above.

1988 Liber 1, Page 344 J.Granger found a DNR monument

Wits. 18" Poplar S64°E 20.55'
18" Poplar S64°W 28.12'
10" Poplar N28°W 24.63'
10" Poplar N42°E 19.18"

B. Description of corner evidence found and/or method applies in restoring or re-establishing corner:


E-2 Found a 1/2" pipe fitting one of K.J. Ostling's witnesses and B. Fullford's survey in section 5, 3.5' West of the DNR Monument.

March 12, 2008 the DNR Monument was reset at the 1/2" pipe location to reflect K.J. Ostling's original location for the DNR Monument.

C. Description of monument for corner and accessories established to perpetuate locating the position of the corner:

E-2 Standard DNR Monument

Wits: N&T N. side 9" Ironwood S83°E 20.89'
N&T E. side 5" Maple clump S14°W 43.16'
N&T NE. side 13" Oak S37°E 22.51'
N&T S. side 4" Ironwood N64°W 8.14'
Fence East 3.5'

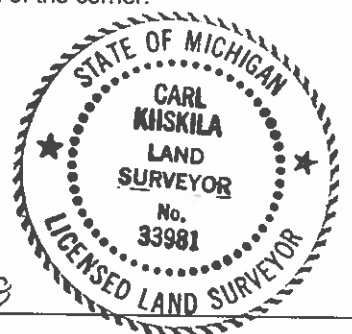

Signed by: Carl T. Kiiskila
Surveyor's Michigan License No.: 33981

Date: 8-18-08