


LAND CORNER RECORDATION CERTIFICATE
Filing Requirement of Act 74, Mich. PA 1970

For Corners In:
Cheboygan
(County)
Located In
Corner Code #
1. Public Land Survey
2. Property Controlling in Section
3. Miscellaneous Property in Section
4. Lot No:
Recorded Plat:
5. Private Claims:

I, Carl T. Kiiskila, in a field survey on March 12, 2008 do hereby state that under requirements of PA 74, Michigan PA of 1970, the corner points mentioned in lines 1 and 2 above were in conformance with regulations and rules therefore as required in the current manual of survey instructions of the United States Department of the Interior, Bureau of Land Management or by a decree of a Court of Law and/or that the corner points mentioned in lines 3, 4 and 5 above were in conformance with the rules of the Michigan Board of Land Surveyors or by a Decree of a Court of Law; established, re-established, monumented, recovered, found as expressed below:

NOTE: Not more than 2 corners, all in the same town and range, may be recorded on this certificate.

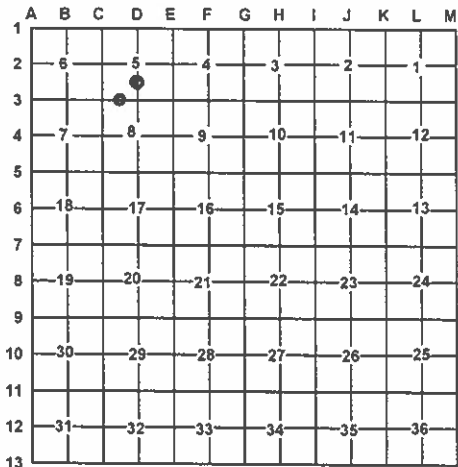

A. Description of original monument and accessories and/or subsequent restoration:
12-This corner position was not established in the original Government Survey.
15-This corner position was not established in the original Government Survey.

B. Description of corner evidence found and/or method applies in restoring or re-establishing corner:
12-Established the Northeast corner of the Southeast quarter of the Southwest quarter of section 5 as per B.L.M. instructions for the subdivision of a section.
15-Established the Southeast corner of the Southwest quarter of the Southwest quarter of section 5 as per B.L.M. instructions for the subdivision of a section.

C. Description of monument for corner and accessories established to perpetuate locating the position of the corner:
12-Set 5/8" x 32" rerod with P.S. cap #33981
Wits: N&T 10" Oak N69°W 55.37'
N&T SE side 10" Maple N41°E 30.70'
N&T NE side 13" Beech S63°E 23.36'
N&T SE side 16" Oak S21°W 14.50'
15-Set 5/8" x 32" rerod with P.S. cap #33981
Wits: N&T S side 6" Cherry N82°E 26.54'
N&T E side 1" Twin Maple S23°E 46.37'
N&T E side 4" Cherry S17°W 26.64'
Carsonite post North 0.70'

Signed by: [Signature of Carl T. Kiiskila]
Surveyor's Michigan License No.: 33981

Date: 9-18-08

