

SURVEY &  
REMONUMENTATION

CHEBOYGAN COUNTY REMONUMENTATION CORNER

MAY 05 1997

COMMISSION

LAND CORNER RECORDATION CERTIFICATE

Filing Requirement of Act 74, Mich. P.A. 1970

For corners in

CHEBOYGAN  
(County)

Located In:

Corner Code #

1. Public Land Survey T 34NR 3W M-3  
T R  
T R  
T R  
T R
2. Property Controlling S T R  
in Section S T R  
3. Miscellaneous S T R  
Property in Section S T R
4. Lot No. , Recorded Plat  
5. Private Claims

RECEIVED  
FOR RECORD

96 OCT -1 PM 4:03

*James G. Gery*  
CLERK/REGISTER  
CHEBOYGAN COUNTY, MICHIGAN

Register of Deeds Stamp & File Number

I, Ronald Bischer, in a field survey on August 28, 19 96,  
do hereby certify that under requirements of P.A. 74, Michigan P.A. of 1970, the corner points mentioned  
in lines 1 and 2 above were in conformance with regulations and rules therefore as required in the current  
manual of survey instructions of the United States Department of the Interior, Bureau of Land  
Management or by a decree of a Court of Law and/or that the corner points mentioned in lines 3, 4 and  
5 above were in conformance with the rules of the Michigan Board of Professional Surveyors or by a  
Decree of a Court of Law; established, re-established, monumented, re-monumented, recovered, found  
as expressed below:

NOTE: Not more than 4 corners, all in the same town and range, may be recorded  
on this certificate.

A. Description of original monument and accessories and/or subsequent restoration:


1840 GLO Survey - John Mullett  
Set Wood Post  
Hemlock 6" S37°W 10 lks  
Hemlock 6" N21°E 34 lks

1991 Norman Quaine #33984  
Found ½" Rod & Cap #14200

1973 Peter Chenard #14200  
Set ½" Rod by single proportion  
Set three witnesses

B. Description of corner evidence found and/or method applied in restoring or reestablishing corner:

Found ½" Rod & Cap # 14200 and two Chenard witnesses  
Replace with Cheboygan County Remonumentation Monument

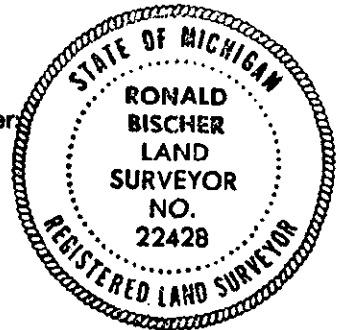


153 PAGE 010 2397

C. Description of monument for corner and accessories established to perpetuate locating the position of the corner:

Cheboygan County Remonumentation Monument

N18°W 19.64' 6" Beech  
N51°E 17.27' 11" Beech  
S72°E 11.79' 18" Aspen  
S15°E 30.67' Power Pole

*Marvin R.*

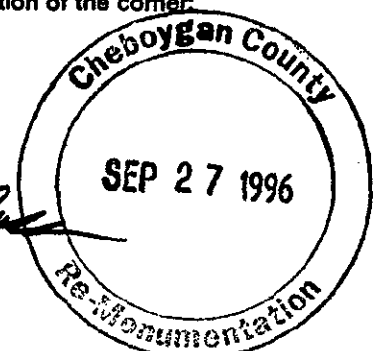

Signed by Ronald R. Bischer

Date Sept. 18, 1996

Surveyor's Michigan License No. 22428