

SURVEY &
REMONUMENTATION

CHEBOYGAN COUNTY REMONUMENTATION MONUMENT

MAY 05 1997

LAND CORNER RECORDATION CERTIFICATE
Filing Requirement of Act 74, Mich. P.A. 1970

For corners in
COMMISSION
CHEBOYGAN
(County)

Located In:

Corner Code #

1. Public Land Survey

T 34N R 3W

M-8

T R

T R

T R

T R

2. Property Controlling
in Section

S T R

S T R

3. Miscellaneous

S T R

Property in Section

S T R

4. Lot No. , Recorded Plat

5. Private Claims

RECEIVED
FOR RECORD

96 OCT -1 PM 4:13

Joanna Spray

CLERK/REGISTER
Register of Deeds Stamp & File Number

I, Ronald Bischer, in a field survey on August 29, 19 96,
do hereby certify that under requirements of P.A. 74, Michigan P.A. of 1970, the corner points mentioned
in lines 1 and 2 above were in conformance with regulations and rules therefore as required in the current
manual of survey instructions of the United States Department of the Interior, Bureau of Land
Management or by a decree of a Court of Law and/or that the corner points mentioned in lines 3, 4 and
5 above were in conformance with the rules of the Michigan Board of Professional Surveyors or by a
Decree of a Court of Law; established, re-established, monumented, re-monumented, recovered, found
as expressed below:

NOTE: Not more than 4 corners, all in the same town and range, may be recorded
on this certificate.

A. Description of original monument and accessories and/or subsequent restoration:

1840 GLO Survey - John Mullett
Set Wood Post
Beech 6" S88° E 17 lks
Beech 5" N38° W 17 lks


1994 Michael Trowbridge #27463
Found 1" pipe
Set 3 witnesses

1973 Orlando Doyle #7319
Set 1" pipe
Set 3 witnesses

B. Description of corner evidence found and/or method applied in restoring or reestablishing corner:

Found 1" pipe and two Doyle witnesses and
three Trowbridge witnesses

Set Cheboygan County Remonumentation Monument in 1" pipe

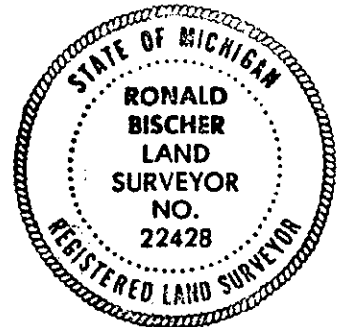


LIBER 010 PAGE 158

C. Description of monument for corner and accessories established to perpetuate locating the position of the corner:

Cheboygan County Remonumentation Monument

N86° W 23.99' 12" Maple
S47° E 34.40' 12" Maple
S30° W 11.35' 5" Maple
N07° E 10.35' 5" Maple

Marvin A. Russ

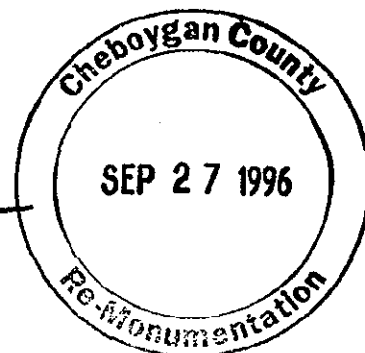

Signed by Ronald R. Bischer

Date Sept. 18, 1996

Surveyor's Michigan License No. 22428