

MICHIGAN
DEPARTMENT OF CONSERVATION
FORESTRY DIVISION

LAND CORNER RECORD

T. 34 N.R. 3 W


Cheboygan COUNTY

DESCRIPTION OF CORNER Section corner common to Sections 4-5-8-9

CORNER MONUMENT 1" pipe with 4" brass cap

DATE MONUMENT PLACED AND WITNESSED 6/12/61

WITNESSES TO CORNER.....

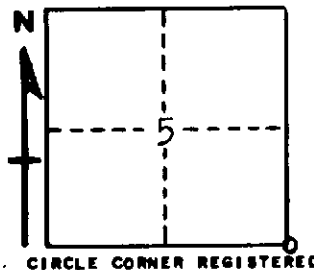

12" Elm - N36E - 12.6 ft

6" Maple - S48W - 32.4 ft

AND

DESCRIPTION IN DETAIL AS TO HOW CORNER WAS LOCATED AND IDENTIFIED OR RESTORED.

This corner was restored by Forestry Division survey crew while making a survey in this area. Set corner on line over 1/4 and section north, at proportionate measurement for latitude. This conforms with old fence line north of Wildwood road, and falls just west of old N*S township road grade. Double proportionate measurement would place corner much too far east to conform with present occupation. This makes mile west about 1 chain short, but Sections 5,8,17,20 all appear to contain a comparable shortage.

SURVEYOR'S SEAL

SIGNED Kenneth J. Ostling DATE 7/5/61
REGISTERED LAND SURVEYOR