

# LAND CORNER RECORDATION CERTIFICATE

Filing Requirement of Act 74, Mich. PA 1970

For Corners In:  
Cheboygan  
(County)

Located In

Corner Code #

1. Public Land Survey T R  
T R  
2. Property Controlling in Section S 25 T 34N R 3W 3  
S T R  
3. Miscellaneous Property in Section S T R  
S T R

4. Lot No: Recorded Plat:

5. Private Claims:

I, Carl T. Kiiskila, in a field survey on April 2, 2002 do hereby state that under requirements of PA 74, Michigan PA of 1970, the corner points mentioned in lines 1 and 2 above were in conformance with regulations and rules therefore as required in the current manual of survey instructions of the United States Department of the Interior, Bureau of Land Management or by a decree of a Court of Law and/or that the corner points mentioned in lines 3, 4 and 5 above were in conformance with the rules of the Michigan Board of Land Surveyors or by a Decree of a Court of Law; established, re-established, monumented, recovered, found as expressed below:

**NOTE: Not more than 2 corners, all in the same town and range, may be recorded on this certificate.**

Register of Deeds Stamp & File Number

	A	B	C	D	E	F	G	H	I	J	K	L	M
1													
2	6		5		4		3		2		1		
3													
4	7		8		9		10		11		12		
5													
6	18		17		16		15		14		13		
7													
8	19		20		21		22		23		24		
9													
10	30		29		28		27		26		25		
11													
12	31		32		33		34		35		36		
13													

A. Description of original monument and accessories and/or subsequent restoration:

3- Kenneth J. Ostling R.L.S. # 10068 set a 1" X 24" pipe for the corner while doing a survey for the Michigan Department of Conservation in 1967.


B. Description of corner evidence found and/or method applies in restoring or re-establishing corner:

3- Found 1" pipe fitting Kenneth J. Ostling's survey in section 25.

C. Description of monument for corner and accessories established to perpetuate locating the position of the corner:

3- Added P.S. cap #33981 to found 1" pipe

wit: 6" Maple S60°W 25.25'  
4" Ironwood N04°W 35.40'  
4" Maple N51°E 11.81'  
4" Maple S62°E 17.01'

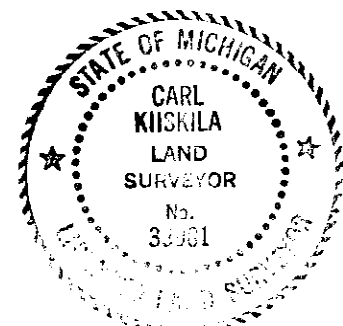

Signed by:

*Carl T. Kiiskila*

Date:

6-26-02

Surveyor's Michigan License No.:

33981