

# SURVEY & REMONUMENTATION

CHEBOYGAN COUNTY REMONUMENTATION CORNER

MAY 10 1995

## LAND CORNER RECORDATION CERTIFICATE

Filing Requirement of Act 74, Mich. P.A. 1970

For corners in

Cheboygan

(County)

COMMISSION

Located In:

Corner Code #

1. Public Land Survey

T 35N R 1W

A-8

T R

T R

T R

2. Property Controlling in Section

S T R

S T R

3. Miscellaneous

S T R

Property in Sec.

S T R

4. Lot No. , Recorded Plat

5. Private Claims

DEC 29 1994  
RECEIVED FOR RECORD  
at 12:55 O'Clock P M

*Joanne Gray*

CLERK/REGISTER  
CHEBOYGAN COUNTY, MICHIGAN  
Register of Deeds Stamp & File Number

	A	B	C	D	E	F	G	H	I	J	K	L	M
2	6	5	4	3	2	1							
3													
4	7	8	9	10	11	12							
5													
6	18	17	16	15	14	13							
7													
8	19	20	21	22	23	24							
9													
10	30	29	28	27	26	25							
11													
12	31	32	33	34	35	36							
13													

I, Richard C. Dunn, in a field survey on August, 19 94, do hereby certify that under requirements of P.A. 74, Michigan P.A. of 1970, the corner points mentioned in lines 1 and 2 above were in conformance with regulations and rules therefore as required in the current manual of survey instructions of the United States Department of the Interior, Bureau of Land Management or by a decree of a Court of Law and/or that the corner points mentioned in lines 3, 4 and 5 above were in conformance with the rules of the Michigan Board of Land Surveyors or by a Decree of a Court of Law; established, re-established, monumented, re-monumented, recovered, found as expressed below:

**NOTE: Not more than 4 corners, all in the same town and range, may be recorded on this certificate.**


A. Description of original monument and accessories and/or subsequent restoration:

G.L.O. John Mullett 1840  
Set wood post  
40" Pine S18°E 25 Links  
10" Birch N28°W 4 Links

B. Description of corner evidence found and/or method applied in restoring or reestablishing corner:

Found 1" Pipe, origin unknown, no witnesses found.

*Martin O. Rose*

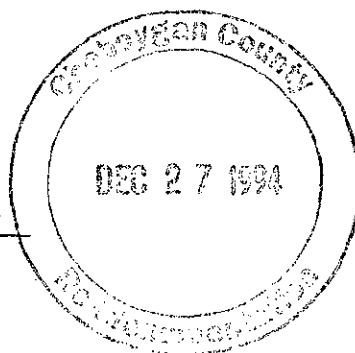

C. Description of monument for corner and accessories established to perpetuate locating the position of the corner:

A-8 Found 1" Pipe, replaced with 5/8" x 30" Iron Bar and 3" aluminum cap and is accepted as a careful and faithful reestablishment of the position of the original corner.  
10" Poplar N45°W 24.18'  
6" W. Birch S80°W 5.72'  
Fence Post S 19.25'  
10" Spruce N50°E 5.26'

LIBER 010 PAGE 102

Signed by *Richard C. Dunn*  
Surveyor's Michigan License No. 12020

Date December 15, 1994

