

SURVEY &
REMONUMENTATION

CHEBOYGAN COUNTY REMONUMENTATION CORNER

MAY 05 1997

LAND CORNER RECORDATION CERTIFICATE
Filing Requirement of Act 74, Mich. P.A. 1970

COMMISSION
For corners in
CHEBOYGAN
(County)

Located In:

Corner Code #

- | | | |
|---|--------------------------|------------|
| 1. Public Land Survey | T <u>35N</u> R <u>1W</u> | <u>M-8</u> |
| | T _____ R _____ | _____ |
| | T _____ R _____ | _____ |
| | T _____ R _____ | _____ |
| 2. Property Controlling
In Section | S _____ T _____ R _____ | _____ |
| | S _____ T _____ R _____ | _____ |
| 3. Miscellaneous
Property in Section | S _____ T _____ R _____ | _____ |
| | S _____ T _____ R _____ | _____ |

4. Lot No. _____, Recorded Plat _____
5. Private Claims _____

I, Ronald Bischer, in a field survey on August 27, 1996,
do hereby certify that under requirements of P.A. 74, Michigan P.A. of 1970, the corner points mentioned
in lines 1 and 2 above were in conformance with regulations and rules therefore as required in the current
manual of survey instructions of the United States Department of the Interior, Bureau of Land
Management or by a decree of a Court of Law and/or that the corner points mentioned in lines 3, 4 and
5 above were in conformance with the rules of the Michigan Board of Professional Surveyors or by a
Decree of a Court of Law; established, re-established, monumented, re-monumented, recovered, found
as expressed below:

NOTE: Not more than 4 corners, all in the same town and range, may be recorded
on this certificate.

A. Description of original monument and accessories and/or subsequent restoration:

1840 GLO Survey - John Hodgson
Set Wood Post.
Beech 10" S28° W 10 lks
Beech 14" N42° E 22 lks

1930 Marcus Schaaf #3104
Set 1½" pipe

1965 Kenneth Ostling #10068
Found 1½" pipe
Set two witnesses

B. Description of corner evidence found and/or method applied in restoring or reestablishing corner:

Found 1½" pipe and Ostling's two witnesses

Set Cheboygan County Remonumentation Monument in 1½" pipe

	A	B	C	D	E	F	G	H	I	J	K	L	M
2	6		5		4		3		2				
3													
4	7		8		9		10		11		12		
5													
6	18		17		16		15		14		13		
7													
8	19		20		21		22		23		24		
9													
10	30		29		28		27		26		25		
11													
12	31		32		33		34		35		36		
13													




LIBER 010 PAGE 163

C. Description of monument for corner and accessories established to perpetuate locating the position of the corner:

Cheboygan County Remonumentation Monument

S31° E 28.20' 20" Maple
N86° W 40.10' 8" Maple
N35° W 39.05' 12" Maple
N68° E 25.22' 8" Maple

Marius A. Ross

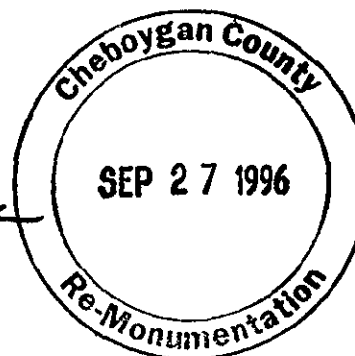

Signed by Ronald R. Bischer

Date Sept. 18, 1996

Surveyor's Michigan License No. 22428