

SURVEY & REMONUMENTATION

CHEBOYGAN COUNTY REMONUMENTATION CORNER

MAY 05 1997

LAND CORNER RECORDATION CERTIFICATE

Filing Requirement of Act 74, Mich. P.A. 1970

For corners in
Cheboygan
(County)

Located In:

Corner Code #

- | | | |
|--------------------------------------|---|-------------|
| 1. Public Land Survey | T <u>35N</u> R <u>1W</u> | <u>M-13</u> |
| | T <u> </u> R <u> </u> | <u> </u> |
| | T <u> </u> R <u> </u> | <u> </u> |
| | T <u> </u> R <u> </u> | <u> </u> |
| 2. Property Controlling in Section | S <u> </u> T <u> </u> R <u> </u> | <u> </u> |
| | S <u> </u> T <u> </u> R <u> </u> | <u> </u> |
| 3. Miscellaneous Property in Section | S <u> </u> T <u> </u> R <u> </u> | <u> </u> |
| | S <u> </u> T <u> </u> R <u> </u> | <u> </u> |
4. Lot No. , Recorded Plat
5. Private Claims

RECEIVED
FOR RECORD

96 OCT -1 PM 3:55

James J. Perry
CLERK/REGISTER
CHEBOYGAN COUNTY, MICHIGAN

Register of Deeds Stamp & File Number

I, Ronald Bischer, in a field survey on August 26, 19 96, do hereby certify that under requirements of P.A. 74, Michigan P.A. of 1970, the corner points mentioned in lines 1 and 2 above were in conformance with regulations and rules therefore as required in the current manual of survey instructions of the United States Department of the Interior, Bureau of Land Management or by a decree of a Court of Law and/or that the corner points mentioned in lines 3, 4 and 5 above were in conformance with the rules of the Michigan Board of Professional Surveyors or by a Decree of a Court of Law; established, re-established, monumented, re-monumented, recovered, found as expressed below:

NOTE: Not more than 4 corners, all in the same town and range, may be recorded on this certificate.

A. Description of original monument and accessories and/or subsequent restoration:

1840 GLO Survey- John Hodgson
set wood post
Hemlock 16" N53° E 16 lks
Hemlock 11" S71° W 6 lks

1969 Orlando Doyle #7319
Set 3/4" pinch pipe

1971 Delmar Porter #15410
Found 3/4" pipe
set two witnesses

B. Description of corner evidence found and/or method applied in restoring or reestablishing corner:

Found 3/4" pipe and both Porter Witnesses

Replaced 3/4" pipe with Cheboygan county Remonumentation Monument




LIBER 010 PAGE 146

C. Description of monument for corner and accessories established to perpetuate locating the position of the corner:

Cheboygan County Remonumentation Monument

South 33.00' 3/4" pipe
S62° W 86.80' 18" Birch
N12° E 29.10' Power pole
N33° W 39.80' Power pole

Marvin A. Rose

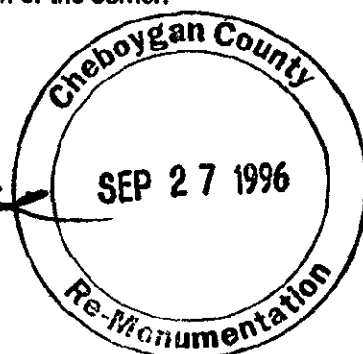

Signed by Ronald R. Bischer

Date Sept. 18, 1996

Surveyor's Michigan License No. 22428