

SURVEY &
REMONUMENTATION

CHEBOYGAN COUNTY REMONUMENTATION CORNER

MAY 03 1995

LAND CORNER RECORDATION CERTIFICATE

Filing Requirement of Act 74, Mich. P.A. 1970

DEC 29 1994

RECEIVED FOR RECORD

12:50 O'Clock

COMMISSION

For corners in
Cheboygan
(County)

Located In:

Corner Code ##

1. Public Land Survey

T 35N R 1W

Meander Corner

T R

Sec. 7

T R

T R

2. Property Controlling
in Section

S T R

S T R

3. Miscellaneous
Property in Sec.

S T R

S T R

James Spray

CLERK/REGISTER
CHEBOYGAN COUNTY, MICHIGAN

Register of Deeds Stamp & File Number

4. Lot No. , Recorded Plat

5. Private Claims

I, Richard C. Dunn, in a field survey on October, 19 94

do hereby certify that under requirements of P.A. 74, Michigan P.A. of 1970, the corner points mentioned in lines 1 and 2 above were in conformance with regulations and rules therefore as required in the current manual of survey instructions of the United States Department of the Interior, Bureau of Land Management or by a decree of a Court of Law and/or that the corner points mentioned in lines 3, 4 and 5 above were in conformance with the rules of the Michigan Board of Land Surveyors or by a Decree of a Court of Law; established, re-established, monumented, re-monumented, recovered, found as expressed below:

NOTE: Not more than 4 corners, all in the same town and range, may be recorded on this certificate.

A. Description of original monument and accessories and/or subsequent restoration:

G.L.O. John Mullett 1840
Meander Post Set
Set Meander Post on North
side of Lake
8" Pine N47°W 41 Links
6" Tamarack N50°E 28 Links

Meander Post set between
corners A-4 and A-5, 22.06
Chains (1,455.96') North from
SW corner, Sec. 7, T35N-R1W

B. Description of corner evidence found and/or method applied in restoring or reestablishing corner:

Corner reestablished on Line between Section Corners A-3 and A-6, T35N-R1W.

Marvin O. Ross




C. Description of monument for corner and accessories established to perpetuate locating the position of the corner:

Meander Corner, Section 7, Set 5/8" x 30" Iron Bar with 2" aluminum Re-Mon Cap, set Meander Corner on the North Shore of Silver Lake on Section Line 1090.89' South of the East 1/4 Corner, Section 7, T35N-R1W and is accepted as a careful and faithful reestablishment of the position of the original corner.

SE Corner House N05°E 98.91'
SW Corner Porch N18°W 101.62'
36" W. Pine N45°E 11.23'
15" Maple S35°W 15.66'
Edge of Water South 14.7'

LIBER 010 PAGE 98

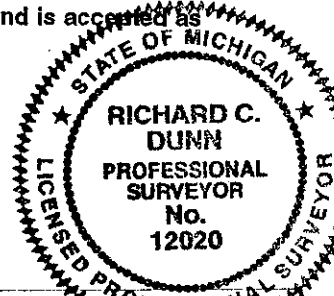

Signed by Richard C. Dunn Date December 15, 1994

Surveyor's Michigan License No. 12020