

SURVEY &
REMONUMENTATION

MAY 03 1995

LAND CORNER RECORDATION CERTIFICATE

Filing Requirement of Act 74, Mich. P.A. 1970

DEC 29 1994

RECEIVED FOR RECORD
10:51 O'Clock P M

For corners in

Cheboygan
(County)

COMMISSION

Located In:

Corner Code #

1. Public Land Survey

T 35N R 1W

Meander Corner

T R

Sec. 18

T R

2

T R

2. Property Controlling
in Section

S T R

3. Miscellaneous

S T R

Property in Sec.

S T R

James Gray

CLERK/REGISTER
CHEBOYGAN COUNTY, MICHIGAN

Register of Deeds Stamp & File Number

4. Lot No. , Recorded Plat

5. Private Claims

	A	B	C	D	E	F	G	H	I	J	K	L	M
2	6		5		4		3		2		1		
3													
4	7		8		9		10		11		12		
5													
6	18		17		16		15		14		13		
7													
8	19		20		21		22		23		24		
9													
10	30		29		28		27		26		25		
11													
12	31		32		33		34		35		36		
13													

I, Richard C. Dunn, in a field survey on October, 19 94, do hereby certify that under requirements of P.A. 74, Michigan P.A. of 1970, the corner points mentioned in lines 1 and 2 above were in conformance with regulations and rules therefore as required in the current manual of survey instructions of the United States Department of the Interior, Bureau of Land Management or by a decree of a Court of Law and/or that the corner points mentioned in lines 3, 4 and 5 above were in conformance with the rules of the Michigan Board of Land Surveyors or by a Decree of a Court of Law; established, re-established, monumented, re-monumented, recovered, found as expressed below:

NOTE: Not more than 4 corners, all in the same town and range, may be recorded on this certificate.


A. Description of original monument and accessories and/or subsequent restoration:

G.L.O. John Mullett 1840
Set Meander Post
10" Pine S17°W 30 Links
8" Cedar S39°E 20 Links
77.12 Chains (5,089.92') from
SW Corner, Section 18, T35N-R1W

B. Description of corner evidence found and/or method applied in restoring or reestablishing corner:

Corner Reestablished on line between Section Corners A-3 and A-6, T35N-R1W.

Morris O. Rose

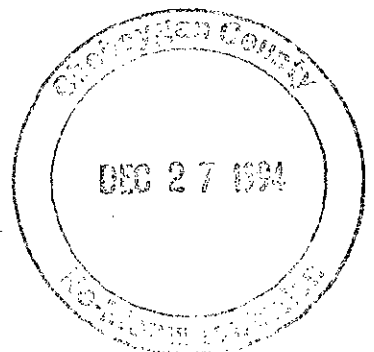

C. Description of monument for corner and accessories established to perpetuate locating the position of the corner:

Meander Corner, Section 7, set 5/8" x 30" Iron Bar with 3" aluminum Re-Mon Cap, set Meander Corner on South Shore of Silver Lake on Section Line 2409.25' North of the W 1/4 Corner, Sec. 18, T35N-R1W and is accepted as a careful and faithful reestablishment of the position of the original corner.
12" Tw. Oak N80°W 18.00'
8" Cedar N36°E 32.42'
8" Oak S15°W 6.12'
21" Hemlock S23°E 27.47'
Edge of Water North 23.3'

LIBER 010 PAGE 99



Signed by *Richard C. Dunn*

Date December 15, 1994

Surveyor's Michigan License No. 12020