

# LAND CORNER RECORDATION CERTIFICATE

Filing Requirement of Act 74, Mich. PA 1970

For Corners In:

Cheboygan

Located In

Corner Code #

(County)

1. Public Land Survey	T	35 N	R 2 W	B-10
	T	35 N	R 2 W	C-9
2. Property Controlling in Section	S	T	R	
	S	T	R	
3. Miscellaneous Property in Section	S	T	R	
	S	T	R	


4. Lot No: \_\_\_\_\_ Recorded Plat: \_\_\_\_\_

5. Private Claims: \_\_\_\_\_

I, Carl T. Kiiskila, in a field survey on July 18, 2001 do hereby state that under requirements of PA 74, Michigan PA of 1970, the corner points mentioned in lines 1 and 2 above were in conformance with regulations and rules therefore as required in the current manual of survey instructions of the United States Department of the Interior, Bureau of Land Management or by a decree of a Court of Law and/or that the corner points mentioned in lines 3, 4 and 5 above were in conformance with the rules of the Michigan Board of Land Surveyors or by a Decree of a Court of Law, established, re-established, monumented, recovered, found as expressed below:

**NOTE: Not more than 2 corners, all in the same town and range, may be recorded on this certificate.**

Register of Deeds Stamp & File Number

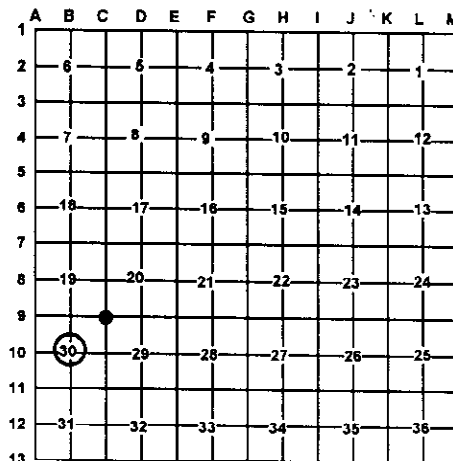

A. Description of original monument and accessories and/or subsequent restoration:

B-10 Norman Caldwell RLS #12018 Dec. 1960 set 1/2" iron rod at intersection of N & S and E & W 1/4 lines. Wits: S55°E 52.47' 8" Poplar, S17°E 36.91' 10" Poplar, S34°W 34.00' 9" Poplar

C-9 GLO Harvey Mullen D.S. 1855  
Set post corner of sections 19, 20, 29, and 30  
Wit: White Pine 24" S52.5°E 56 links  
White Pine 24" N44°E 56 links

Liber 1 Page 325 Ronald R. Bischer RLS #22428 Oct. 1983 found 1/2" rod by Caldwell 1960 Wit: S17°E 36.91' 14" Aspen, S34°W 34.00' 12" Aspen S41°E 55.60' 14 Aspen

Delmer Porter RLS #15410 Oct. 1983 1/2" rod Wit: S17°W 36.91' 10" Aspen, S34°W 34.00' 12" Aspen S41°E 55.60' 14 Aspen

Thomas L. Fabis LS #31591 Dec. 1991 Existing 1/2" iron rod Wit: 3" Jack Pine N65°E 42.48', 6" Aspen N54°W 53.88', 3" Aspen S14°W 3.29', 4" Oak N08°W 35.63'



B. Description of corner evidence found and/or method applies in restoring or re-establishing corner:

B-10 Found 1/2" iron rod as set by Norman Caldwell RLS#12018 while doing a survey in section 30 for the Michigan State Highway Department in December of 1960. I found this corner to be 4.7' North of the East - West one-quarter line and 15.7' East of the North - South one-quarter line but held this position due to the length of time since its placement and the wide use by surveyors in the area.

C-9 Found and accepted a 1 1/2" iron pipe with witnesses of unknown origin, but fits well with other corners in section 30.

C. Description of monument for corner and accessories established to perpetuate locating the position of the corner:

B-10 Left 1/2" iron rod in place

Wit: 2" Cherry	S21°E	29.23'
5" Aspen	South	3.26'
5" Oak	S45°E	48.03'
Chain link fence	North	36.7'
*12" Aspen stump	S34°W	33.8'

\*old witnesses by others

C-9 Left 1 1/2" iron pipe in place

Wit: 24" Oak	N60°E	13.04'
5" Maple	North	26.89'
6" Balsam	N50°E	45.53'
10" Oak	N81°W	44.72'
Pine Stump "NBT"	S65°W	19.9'

Signed by:

Carl T. Kiiskila

Date:

1 - 10 - 02

Surveyor's Michigan License No.: 33981