

FEB 26 1998

1997 CHEBOYGAN COUNTY, STATE OF MICHIGAN REMONUMENTATION

LAND CORNER RECORDATION CERTIFICATE
Filing Requirement of Act 74, Mich. P.A. 1970

SECTION

12-22-97

For corners in

CHEBOYGAN
(County)

Located In:

Corner Code #

1. Public Land Survey

T 35 R 3W L-3
T R
T R
T R
T R
S T R
S T R
S T R
S T R

2. Property Controlling
in Section

3. Miscellaneous
Property in Sec.

RECEIVED FOR RECORD

at 9:16 O'Clock A A

Joanne Spray

CLERK/REGISTER

CHEBOYGAN COUNTY, MICHIGAN

Register of Deeds Stamp & File Number

4. Lot No. , Recorded Plat
5. Private Claims

I, Ronald Bischer, in a field survey on Oct 1, 19 97 do hereby state that under requirements of P.A. 74, Michigan P.A. of 1970, the corner points mentioned in lines 1 and 2 above were in conformance with regulations and rules therefore as required in the current manual of survey instructions of the United States Department of the Interior, Bureau of Land Management or by a decree of a Court of Law and /or that the corner points mentioned in lines 3, 4 and 5 above were in conformance with the rules of the Michigan Board of Land Surveyors or by a Decree of a Court of Law; established, re-established, monumented, recovered, found as expressed below:

NOTE: Not more than 2 corners, all in the same town and range, may be recorded on this certificate.

A. Description of original monument and accessories and/or subsequent restoration:

L-3
GLO notes
Harvey Mellen
Set Post
18" White pine S45° E 30 lks
8" Beech N48° W 7 lks

1955 Orlando Doyle #7319
set 3/4" pipe and three witnesses

B. Description of corner evidence found and/or method applied in restoring or reestablishing corner:



L-3
Found 3/4" pipe and three witnesses stumps
also found O.B.T. White pine stump
S45° E 30 lks
Set 5/8" rod and Remon cap in 3/4" pipe

LIBER 011 PAGE 64

C. Description of monument for corner and accessories established to perpetuate locating the position of the corner:

L-3
5/8" rod and Remon cap in 3/4" pipe

S08° E 20.18' 14" Oak
N56° E 12.74' 9" Maple
N71° W 19.83' 9" Oak
West 9.22' T Iron #10710
East 16.80' T Iron #10710

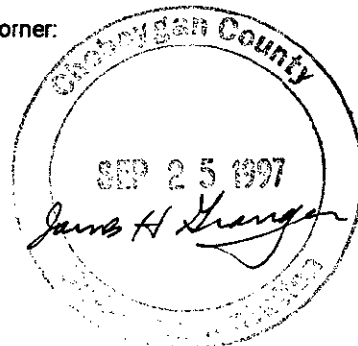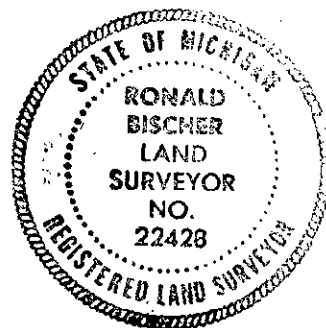

Signed by Ronald P. Bischer
Surveyor's Michigan License No. 22428

Date 10-13-97