

FEB 26 1998

1997 CHEBOYGAN COUNTY, STATE OF MICHIGAN REMONUMENTATION

LAND CORNER RECORDATION CERTIFICATE
Filing Requirement of Act 74, Mich. P.A. 1970

SECTION

For corners in

CHEBOYGAN
(County)

Located In:

Corner Code #

1. Public Land Survey

T35NR 3W

L-5

2. Property Controlling
in Section

S T R

3. Miscellaneous
Property in Sec.

S T R

4. Lot No. , Recorded Plat

5. Private Claims

12-22-97
RECEIVED FOR RECORD

at 9:17 O'Clock A M

Joanne Spray

CLERK/REGISTER
CHEBOYGAN COUNTY, MICHIGAN

Register of Deeds Stamp & File Number

I, Ronald Bischer, in a field survey on Oct 2, 19 97 do hereby state that under requirements of P.A. 74, Michigan P.A. of 1970, the corner points mentioned in lines 1 and 2 above were in conformance with regulations and rules therefore as required in the current manual of survey instructions of the United States Department of the Interior, Bureau of Land Management or by a decree of a Court of Law and/or that the corner points mentioned in lines 3, 4 and 5 above were in conformance with the rules of the Michigan Board of Land Surveyors or by a Decree of a Court of Law; established, re-established, monumented, recovered, found as expressed below:

NOTE: Not more than 2 corners, all in the same town and range, may be recorded on this certificate.

A. Description of original monument and accessories and/or subsequent restoration:

L-5

GLO Notes

Harvey Mellen

1855 Resurvey

Set post

14" Yellow Pine N46° E 21' 1ks

12" Yellow Pine South 11 1ks

1953 Orlando Doyle #7319

Set Conc. Mon. and three witnesses

1982 Ronald Bischer #22428

Found Conc. Mon. and three


Doyle witnesses

B. Description of corner evidence found and/or method applied in restoring or reestablishing corner:

L-5

Found Conc. Mon. and three Doyle witnesses

Set Remon Cap on Conc. Mon.

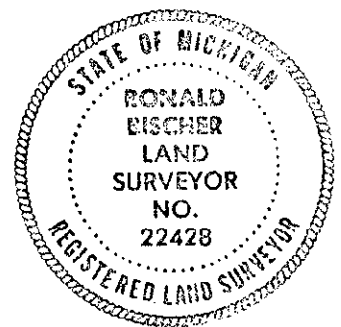

LIBER 011 PAGE 65

C. Description of monument for corner and accessories established to perpetuate locating the position of the corner:

L-5

Remon cap on Conc. Mon

N25° E 29.10' 15" Oak

N79° E 33.40' 17" Norway


S23° E 16.80' 18" Oak

S83° W 7.56' 6" White Oak

Doyle witness

Doyle witness

Doyle witness

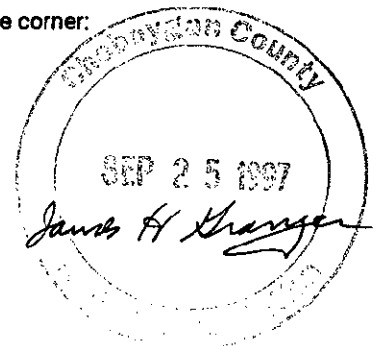

Signed by Ronald R. Bischer

Date Oct. 10, 1997

Surveyor's Michigan License No. 22428