

1997 CHEBOYGAN COUNTY, STATE OF MICHIGAN REMONUMENTATION

LAND CORNER RECORDATION CERTIFICATE
Filing Requirement of Act 74, Mich. P.A. 1970

For corners in

CHEBOYGAN
(County)

Located In:

Corner Code #

1. Public Land Survey

T	R	
T	R	
T	R	
T	R	

2. Property Controlling
in Section

S1 T35NR3W MC 1

3. Miscellaneous
Property in Sec.

S T R
S T R
S T R

4. Lot No. , Recorded Plat

5. Private Claims

I, Ronald Bischer, in a field survey on Oct 1, 1997 do hereby state that under requirements of P.A. 74, Michigan P.A. of 1970, the corner points mentioned in lines 1 and 2 above were in conformance with regulations and rules therefore as required in the current manual of survey instructions of the United States Department of the Interior, Bureau of Land Management or by a decree of a Court of Law and /or that the corner points mentioned in lines 3, 4 and 5 above were in conformance with the rules of the Michigan Board of Land Surveyors or by a Decree of a Court of Law; established, re-established, monumented, recovered, found as expressed below:

NOTE: Not more than 2 corners, all in the same town and range, may be recorded on this certificate.

A. Description of original monument and accessories and/or subsequent restoration:


MC Between K-2 & K-3
GLO Notes
Harvey Mellen
1855 Resurvey
14" Yellow Pine as Meander Corner
12" Yellow Pine S40° E 24 lks

SURVEY &
REMONUMENTATION

FEB 26 1998

SECTION

	A	B	C	D	E	F	G	H	I	J	K	L	M
1													
2	6		5		4		3		2		1		
3													
4	7		8		9		10		11		12		
5													
6	18		17		16		15		14		13		
7													
8	19		20		21		22		23		24		
9													
10	30		29		28		27		26		25		
11													
12	31		32		33		34		35		36		
13													

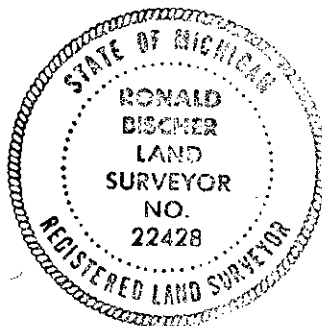

B. Description of corner evidence found and/or method applied in restoring or reestablishing corner:


MC
Traversed North from Southwest corner of Section 1 found Doyle Cap and Iron at N0° 36'42"E 1818.98 feet and found George Young cap and Iron at N0° 36'42"E 1975.76 feet Set 5/8" Rod and Remon cap at N0° 36'42"E 2139.09 feet at high water line of Burt Lake. Original distace was 2166.12 feet.

C. Description of monument for corner and accessories established to perpetuate locating the position of the corner:

MC
5/8" Rod and Remon cap

N26° E 33.26' 4" White Pine
S88° E 19.33' 9" White Pine
S24° E 7.66' 6" White Pine
S05° W 25.19' 22" Yellow Pine

LIBER 011 PAGE 48

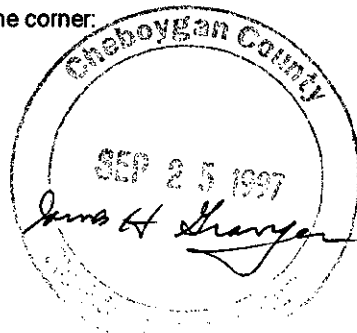

Signed by Ronald R. Bischer
Surveyor's Michigan License No. 22428

Date Oct. 10, 1997