

1997 CHEBOYGAN COUNTY, STATE OF MICHIGAN REMONUMENTATION

LAND CORNER RECORDATION CERTIFICATE
Filing Requirement of Act 74, Mich. P.A. 1970

For corners in

CHEBOYGAN
(County)

Located In:

Corner Code #

1. Public Land Survey

2. Property Controlling
in Section

3. Miscellaneous
Property in Sec.

4. Lot No. _____, Recorded Plat _____
5. Private Claims _____

I, Ronald Bischer, in a field survey on Oct 1, 1997 do hereby state that under requirements of P.A. 74, Michigan P.A. of 1970, the corner points mentioned in lines 1 and 2 above were in conformance with regulations and rules therefore as required in the current manual of survey instructions of the United States Department of the Interior, Bureau of Land Management or by a decree of a Court of Law and /or that the corner points mentioned in lines 3, 4 and 5 above were in conformance with the rules of the Michigan Board of Land Surveyors or by a Decree of a Court of Law; established, re-established, monumented, recovered, found as expressed below:

NOTE: Not more than 2 corners, all in the same town and range, may be recorded on this certificate.

A. Description of original monument and accessories and/or subsequent restoration:

M.C. Between J-3 & K-3

GLO Notes
Harvey Mellen
1855 Resurvey
Set Wood Post
14" Yellow Pine S28° E 26 lks
8" Aspen N46° E 50 Lks

B. Description of corner evidence found and/or method applied in restoring or reestablishing corner:


MC
Set 5/8" Rod & Remon Cap at high water line of Burt Lake
on original bearing from southwest corner of section 1

C. Description of monument for corner and accessories established to perpetuate locating the position of the corner:

M.C.
5/8" Rod and Remon cap

West 1.60' 6" Birch
S13° E 15.42' 16" Yellow Pine
N76° E 18.68' 11" Yellow Pine
North 11.87' 6" Cedar

LIBER 011 PAGE 49

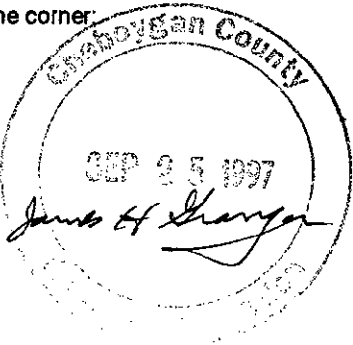

Signed by Ronald R. Bischer
Surveyor's Michigan License No. 22428

Date Oct. 10, 1997