

LAND CORNER RECORDATION CERTIFICATE
Filing Requirement of Act 74, Mich. P.A. 1970

For corners in

CHEBOYGAN
(County)

Located In:

Corner Code #

1. Public Land Survey

T R
T R
T R
T R

2. Property Controlling
in Section

S 14 T 35 R 3W

MC 4

3. Miscellaneous
Property in Sec.

S T R
S T R
S T R

10-22-97
RECEIVED FOR RECORD
of 9:03 O'Clock A.M.
Joanne Spray
CLERK/REGISTER
CHEBOYGAN COUNTY, MICHIGAN
Register of Deeds Stamp & File Number

4. Lot No. , Recorded Plat
5. Private Claims

I, Ronald Bischer, in a field survey on Oct 8, 1997 do hereby state that under requirements of P.A. 74, Michigan P.A. of 1970, the corner points mentioned in lines 1 and 2 above were in conformance with regulations and rules therefore as required in the current manual of survey instructions of the United States Department of the Interior, Bureau of Land Management or by a decree of a Court of Law and/or that the corner points mentioned in lines 3, 4 and 5 above were in conformance with the rules of the Michigan Board of Land Surveyors or by a Decree of a Court of Law; established, re-established, monumented, recovered, found as expressed below:

NOTE: Not more than 2 corners, all in the same town and range, may be recorded on this certificate.

	A	B	C	D	E	F	G	H	I	J	K	L	M
1													
2	6			5			4			3		2	1
3													
4	7			8			9			10		11	12
5													
6	18			17			16			15		14	13
7													
8	19			20			21			22		23	24
9													
10	30			29			28			27		26	25
11													
12	31			32			33			34		35	36

A. Description of original monument and accessories and/or subsequent restoration:

MC Between J-7 and K-7 at Burt Lake
GLO Notes
Harvey Mellen
1855 Resurvey
10" Lynn for Meander Corner
9" Cedar N49 W 14 lks

1962 Dean DelaMater #5779
Found Conc. Mon. tag # 10710
N40° E 16.9' 6" Ash
N60° E 31.9' 10" Ash

B. Description of corner evidence found and/or method applied in restoring or reestablishing corner:

MC
Found Conc. Monument with Tag #10710
and a scribed 4x4

SURVEY &
REMONUMENTATION

FEB 26 1998



SECTION

C. Description of monument for corner and accessories established to perpetuate locating the position of the corner:

MC
Conc. Monument with tag# 10710

East 141.36' Section Corner Conc. Monument
N25° E 27.45' 17" Lynn Tag #16041
N43° E 42.48' 20" Cedar
N22° W 8.30' 7" Ash tag # 16041
S46° E 18.51' 17" Elm

LIBER 011 PAGE 51

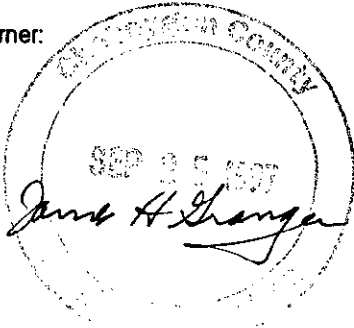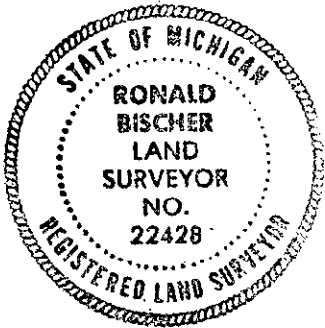

Signed by Ronald R. Bischer
Surveyor's Michigan License No. 22428

Date Oct. 10, 1997