

1997 CHEBOYGAN COUNTY, STATE OF MICHIGAN REMONUMENTATION

LAND CORNER RECORDATION CERTIFICATE
Filing Requirement of Act 74, Mich. P.A. 1970

For corners in

CHEBOYGAN
(County)

Located In:

Corner Code #

1. Public Land Survey

T___ R___
T___ R___
T___ R___
T___ R___

2. Property Controlling
in Section

S24 T35NR3W

3. Miscellaneous
Property in Sec.

S___ T___ R___
S___ T___ R___
S___ T___ R___

MC 6

RECEIVED FOR RECORD

at 9:05 O'Clock A M

Joanne Spray

CLERK/REGISTER

CHEBOYGAN COUNTY, MICHIGAN

Register of Deeds Stamp & File Number

4. Lot No. _____, Recorded Plat _____
5. Private Claims _____

I, Ronald Bischer, in a field survey on Oct 8, 19 97 do hereby state that under requirements of P.A. 74, Michigan P.A. of 1970, the corner points mentioned in lines 1 and 2 above were in conformance with regulations and rules therefore as required in the current manual of survey instructions of the United States Department of the Interior, Bureau of Land Management or by a decree of a Court of Law and/or that the corner points mentioned in lines 3, 4 and 5 above were in conformance with the rules of the Michigan Board of Land Surveyors or by a Decree of a Court of Law; established, re-established, monumented, recovered, found as expressed below:

NOTE: Not more than 2 corners, all in the same town and range, may be recorded on this certificate.

	A	B	C	D	E	F	G	H	I	J	K	L	M
1													
2		6		5		4		3		2		1	
3													
4		7		8		9		10		11		12	
5													
6		18		17		16		15		14		13	
7													
8		19		20		21		22		23		24	
9													
10		30		29		28		27		26		25	
11													
12		31		32		33		34		35		36	
13													

A. Description of original monument and accessories and/or subsequent restoration:

M.C. Between K-9 and L-9
GLO notes
Harvey Mellen
1855 Resurvey
Set Post
6" Spruce Pine S29¹/₂° W 47 lks
6" Spruce Pine S72° E 61 lks

1954 Joseph Doyle #3177
Set conc. Mon.

B. Description of corner evidence found and/or method applied in restoring or reestablishing corner:

M.C.
Found Conc. Mon.
Set Remon Cap on top

SURVEY &
REMONUMENTATION

FEB 26 1998



SECTION

C. Description of monument for corner and accessories established to perpetuate locating the position of the corner:

M.C.
Remon cap on conc. mon.

N32° E 53.21' 13" Scotch Pine
N85° E 46.41' 8" Ash
S45° E 5.22' 10" Norway
S62° W 9.37' 11" White Pine

LIBER 011 PAGE 53

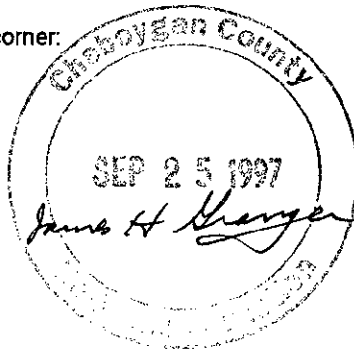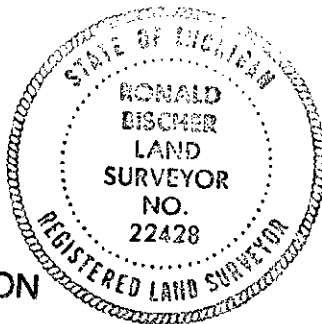

Signed by Ronald R. Bischer
Surveyor's Michigan License No. 22428

Date Oct. 10, 1997