

# LAND CORNER RECORDATION CERTIFICATE

Filing Requirement of Act 74, Mich. PA 1970

For Corners In:  
Cheboygan  
(County)

Located In

Corner Code #

1. Public Land Survey	T	35N	R	1E	I-7
	T	35N	R	1E	H-7
2. Property Controlling in Section	S	T	R		
	S	T	R		
3. Miscellaneous Property in Section	S	T	R		
	S	T	R		


4. Lot No: Recorded Plat:

5. Private Claims:

I, Carl T. Kiiskila, in a field survey on March 29, 2011 do hereby state that under requirements of PA 74, Michigan PA of 1970, the corner points mentioned in lines 1 and 2 above were in conformance with regulations and rules therefore as required in the current manual of survey instructions of the United States Department of the Interior, Bureau of Land Management or by a decree of a Court of Law and/or that the corner points mentioned in lines 3, 4 and 5 above were in conformance with the rules of the Michigan Board of Land Surveyors or by a Decree of a Court of Law; established, re-established, monumented, recovered, found as expressed below:

**NOTE: Not more than 2 corners, all in the same town and range, may be recorded on this certificate.**

Register of Deeds Stamp & File Number

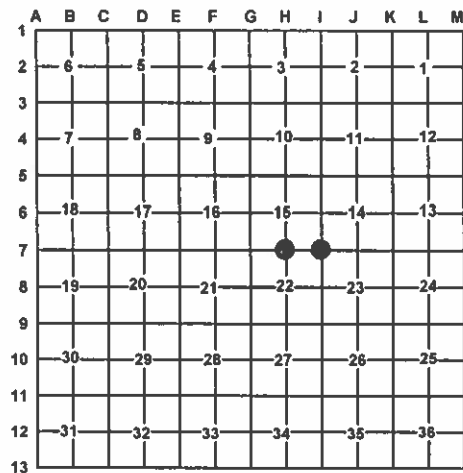

A. Description of original monument and accessories and/or subsequent restoration:

I-7 – Section Corner comm. to sec.'s 14,15,22,23, T35N, R01E

1840 – GLO – Brevort- Set post cor. of sects. 14,15,22 & 23  
Sp. Pine 12 N22 ½ °W 50  
Sp. Pine 12 N49°E 45

1975 – L.C.R.C. – L.1, p.165 – Delmer E. Porter, P.S.#15410  
Fd. 2" pipe buried in trail intersection.  
N75°E 43.50' 24" N. Pine  
S25°E 24.17' 10" J. Pine  
N15°W 33.62' 8" N. Pine

2000 – Road Easement Description – Brian K. Fullford, P.S.#41099  
– Fd. 2" iron pipe. N72°E 43.72' 26" R. Pine; S26°E 24.02'  
12" J. Pine; S39°W 71.77' 12" R. Pine; N14°W 33.58'  
14" R. Pine

H-7 – ¼ Corner comm. to sec.'s 15 & 22, T35N, R01E

1840 – GLO – Brevort- Set qr. Section post.  
Y. Pine 18 S66°E 50  
Y. Pine 16 N24°W 76

1975 – L.C.R.C. – L.1, p.165 – Delmer E. Porter, P.S.#15410  
Fd. 3" pipe buried in trail intersection.  
N30°E 54.63' 16" Oak  
N71°E 64.46' 20" Oak  
S18°W 48.08' 24" N. Pine

B. Description of corner evidence found and/or method applies in restoring or re-establishing corner:

I-7 – Section Corner comm. to sec.'s 14,15,22,23, T35N, R01E

Found and accepted 2" dia. pipe in trail road intersection as the best available evidence for the position of the original corner. Found ½" bent rebar S07°E 4.88' of no record.  
Found no other evidence to dispute the location for the corner.

H-7 – ¼ Corner comm. to sec.'s 15 & 22, T35N, R01E

Found and accepted 3" dia. pipe in trail road intersection as the best available evidence for the position of the original corner. Found no other evidence to dispute the location for the corner.

C. Description of monument for corner and accessories established to perpetuate locating the position of the corner:

I-7 – Section Corner comm. to sec.'s 14,15,22,23, T35N, R01E

2" diameter pipe.

Wit: \*N66°E 43.47' to set N&T on NW side 28" R. Pine  
\*S31°E 24.18' to set N&T on NE side 13" J. Pine  
S07°E 4.88' to fd. bent ½" bar  
\*S34°W 71.88' to set N&T on E side 14" R. Pine  
\*N19°W 33.42' to set N&T on NE side 15" R. Pine

\* Witness of previous record.

Carl T. Kiiskila

Surveyor's Michigan License No.: 33981

H-7 – ¼ Corner comm. to sec.'s 15 & 22, T35N, R01E

3" diameter pipe.

Wit: N23°E 78.04' to set N&T on W side 24" R. Oak  
\*N76°E 64.44' to set N&T on S side 16"&20" Tw. R. Oak  
\*S19°W 47.96' to set N&T on NW side 23" R. Pine  
N45°W 40.37' to set N&T on NE side 12" R. Pine  
\*N25°E 54.15' to fd. face blaze in 16" Oak stump

\* Witness of previous record.

5-1-12

