

SEP 24 1999

1998 CHEBOYGAN COUNTY, STATE OF MICHIGAN REMONUMENTATION

LAND CORNER RECORDATION CERTIFICATE
Filing Requirement of Act 74, Mich. P.A. 1970

SECTION

For corners in

Cheboygan
(County)

Located in:

Corner Code #

Forest Township
1. Public Land Survey
Waverly Township

T 34N R 1E

T 35N R 1E

T R

T R

G-1
G-13 ✓

2. Property Controlling
in Section

3. Miscellaneous
Property in Sec.

S

S

S

S

RECEIVED FOR RECORD 12-7-98
at 9:39 O'Clock A M

Joanne Spray

CLERK/REGISTER
CHEBOYGAN COUNTY, MICHIGAN

Register of Deeds Stamp & File Number

4. Lot No. _____, Recorded Plat _____
5. Private Claims _____

I, Ronald Bischer, in a field survey on 7-17, 1998, do hereby state that under requirements of P.A. 74, Michigan P.A. of 1970, the corner points mentioned in lines 1 and 2 above were in conformance with regulations and rules therefore as required in the current manual of survey instructions of the United States Department of the Interior, Bureau of Land Management or by a decree of a Court of Law and /or that the corner points mentioned in lines 3, 4 and 5 above were in conformance with the rules of the Michigan Board of Land Surveyors or by a Decree of a Court of Law; established, re-established, monumented, recovered, found as expressed below:


NOTE: Not more than 2 corners, all in the same town and range, may be recorded on this certificate.

	A	B	C	D	E	F	G	H	I	J	K	L	M
1													
2	6		5		4			3		2		1	
3													
4	7		8		9			10		11		12	
5													
6	18		17		16			15		14		13	
7													
8	19		20		21			22		23		24	
9													
10	30		29		28			27		26		25	
11													
12	31		32		33			34		35		36	
13													

A. Description of original monument and accessories and/or subsequent restoration:

G-1
1840 John Hodgson
1855 George Cannon (Resurvey)
set wood post and 4 witnesses
March 22, 1975 Delmer Porter #15410
Found 1" pipe in pond
set 2 witnesses

Sept 12, 1977 Delmer Porter #15410
found 1" Pipe in pond
2 witnesses

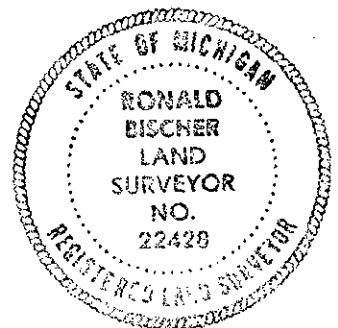


B. Description of corner evidence found and/or method applied in restoring or reestablishing corner:

G-1
Found 1" pipe in pond
set 5/8" rod and remon cap inside 1" pipe

C. Description of monument for corner and accessories established to perpetuate locating the position of the corner:

G-1
5/8" rod and remon cap
S59°W 11.25' 9" Norway O.W.
N87°W 22.20' 10" Norway O.W.
S50°W 19.70' 20" Oak
S04°E 25.55' 6" J. Pine
6' to the shore

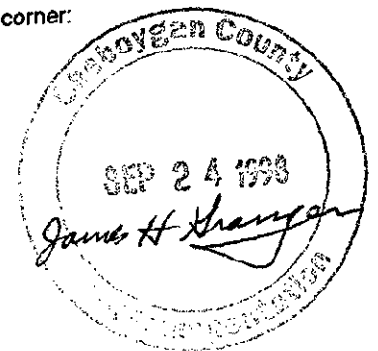

LIBER 011 PAGE 104

Signed by Ronald R. Bischer
Surveyor's Michigan License No. 22428

Date Sept. 28, 1998