

MAR 22 1999

1998 CHEBOYGAN COUNTY, STATE OF MICHIGAN REMONUMENTATION

LAND CORNER RECORDATION CERTIFICATE
Filing Requirement of Act 74, Mich. P.A. 1970

SECTION

For corners in

Cheboygan Located In: Corner Code #
(County)
Forest Township
1. Public Land Survey T34NR 1E I-1
Waverly Township → T35NR 1E I-13
T R
T R
T R
2. Property Controlling S T R
in Section S T R
3. Miscellaneous S T R
Property in Sec. S T R

RECEIVED FOR RECORD 12-7-98
at 9:42 O'Clock A M

Joanne Spray

CLERK/REGISTER
CHEBOYGAN COUNTY, MICHIGAN

Register of Deeds Stamp & File Number

4. Lot No. , Recorded Plat
5. Private Claims

I, Ronald Bischer, in a field survey on 7-22, 19 98 do hereby state that under requirements of P.A. 74, Michigan P.A. of 1970, the corner points mentioned in lines 1 and 2 above were in conformance with regulations and rules therefore as required in the current manual of survey instructions of the United States Department of the Interior, Bureau of Land Management or by a decree of a Court of Law and/or that the corner points mentioned in lines 3, 4 and 5 above were in conformance with the rules of the Michigan Board of Land Surveyors or by a Decree of a Court of Law; established, re-established, monumented, recovered, found as expressed below:

NOTE: Not more than 2 corners, all in the same town and range, may be recorded on this certificate.

| | A | B | C | D | E | F | G | H | I | J | K | L | M |
|----|----|---|----|---|----|---|----|---|----|---|----|---|---|
| 1 | | | | | | | | | | | | | |
| 2 | 6 | | 5 | | 4 | | 3 | | 2 | | 1 | | |
| 3 | | | | | | | | | | | | | |
| 4 | 7 | | 8 | | 9 | | 10 | | 11 | | 12 | | |
| 5 | | | | | | | | | | | | | |
| 6 | 18 | | 17 | | 16 | | 15 | | 14 | | 13 | | |
| 7 | | | | | | | | | | | | | |
| 8 | 19 | | 20 | | 21 | | 22 | | 23 | | 24 | | |
| 9 | | | | | | | | | | | | | |
| 10 | 30 | | 29 | | 28 | | 27 | | 26 | | 25 | | |
| 11 | | | | | | | | | | | | | |
| 12 | 31 | | 32 | | 33 | | 34 | | 35 | | 36 | | |
| 13 | | | | | | | | | | | | | |


A. Description of original monument and accessories and/or subsequent restoration:

I-1
1840 John Hodgson
1855 George Cannon (Resurvey)
set wood post and 4 witnesses
Nov. 20, 1922 David Bowen
set 3" sq. cedar post with 2" gas pipe
June 5, 1975 Delmer Porter #15410
set 1/2" rod by SP and 3 witnesses

June 6, 1975 Delmer Porter #15410
1/2" rod and cap 3 witnesses
July 5, 1994 Norman Quaine #33984
found 1/2" rod and cap and 4 witnesses

B. Description of corner evidence found and/or method applied in restoring or reestablishing corner:


I-1
found 1/2" rod and cap
replaced with 5/8" rod and remon cap

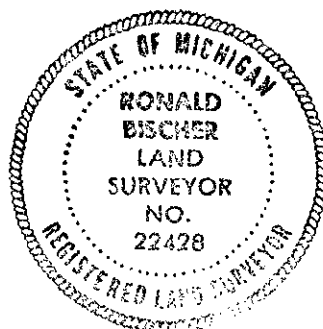

C. Description of monument for corner and accessories established to perpetuate locating the position of the corner:

I-1
5/8" rod and remon cap
N83°W 35.35' 5" Aspen O.W.
N48°W 48.44' 10" Twin maple O.W.
N19°W 31.95' 10" Maple O.W.
S23°E 103.39' 10" Twin Apple O.W.

LIBER 011 PAGE 107

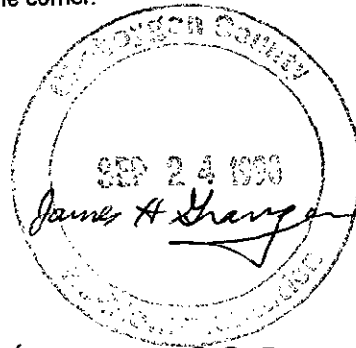

Signed by Ronald R. Bischer
Surveyor's Michigan License No. 22428

Date Sept. 28, 1998